AD ADA ADAAG ADDL ADJ AFF ALT ALUM APPROX ARCH	AIR CONDITIONING AREA DRAIN AMERICANS WITH DISABILITIES ACT ADA ACCESSIBILITY GUIDELINES ADDITIONAL ADJUSTABLE ABOVE FINISH FLOOR ALTERNATE ALUMINUM APPROXIMATE ARCHITECTURAL AUDIO VISUAL
	BOTTOM OF (SEE OTHER WORD) BUILDING BASEMENT
CAT CB CI CIP CJ CL CLG CLR	CAST-IN-PLACE CONTROL JOINT / CONSTRUCTION JOINT CENTER LINE CEILING CLEAR CENTIMETER CEMENT BOARD CONCRETE MASONRY UNIT CLEANOUT COLUMN CONCRETE CONTINUOUS
D DB DEG DEMO DEPT DF DIA DIFF DIM DL DN DR DR DR DR DR DW DWG	DECIBEL DEGREE DEMOLITION DEPARTMENT DETAIL DRINKING FOUNTAIN DIAMETER DIFFUSER DIMENSION DEAD LOAD DOWN DOOR DRAIN DISHWASHER DRAWING
EMERG ENCL EP EQ EQUIP EWC EXH	ELECTRICAL PANELBOARD EQUAL

А

_	
:/	FACE OF (SEE OTHER WORD)
Ā	FIRE ALARM
Đ	FLOOR DRAIN
	FIRE DEPARTMENT CONNECTION
DN	FOUNDATION
E	FIRE EXTINGUISHER
EC	FIRE EXTINGUISHER CABINET
EQ	FOOD EQUIPMENT
F	FINISH FLOOR
F&E	FURNITURE, FIXTURES & EQUIPMENT
HC	FIRE HOSE CABINET
IN	FINISH
Ľ	FLOOR
	FLUORESCENT
-	FINISHED OPENING
	FIRE RETARDANT TREATED WOOD
S	FIRE STOPPING
	FEET/FOOT
TG	FOOTING FURNITURE
URIN	FURNITURE
3	
SA BA	GAUGE / GAGE
GALV	GALVANIZED
SC	GENERAL CONTRACTOR, GENERAL CONTRACT
GFRC	GLASS FIBER REINFORCED CONCRETE
GFRG	GLASS FIBER REINFORCED GYPSUM
GFRP	GLASS FIBER REINFORCED PLASTIC
R	GRADE
GWB	GYPSUM WALLBOARD
ł	
ΙB	HOSE BIBB
IC	HANDICAPPED
IM	HOLLOW METAL
10	HOLD-OPEN
-	
IP IP	HIGH POINT
IR IR	HOUR
IRC	HOSE REEL CABINET
ISS	HOLLOW STRUCTURAL SECTION HEIGHT
IT IVAC	HEATING, VENTILATING, AIR CONDITIONING
IVAC IW	HOT WATER
1 V V	HOT WATER
СВ	INTEGRAL COVE BASE
CC	INTERNATIONAL CODE COUNCIL
D	INSIDE DIAMETER / DIMENSION
Ν	INCH
NFO	INFORMATION
NT	INTERIOR
NV	INVERT
C	JANITOR'S CLOSET
ST	JOIST
Т	JOINT
,	
ς	KIP (1000 LB)
κ (G	KILOGRAM
KIT	KITCHEN
AB	LABORATORY
AT	LATERAL
AV	LAVATORY
.B	POUND
.F	LINEAR FOOT
L	LIVE LOAD
LH	LONG LEG HORIZONTAL
LV	LONG LEG VERTICAL
.P	LOW VOLTAGE
T	LIGHT
V	LOW VOLTAGE

M MAINT MAX MCC MDF MDO MECH MER MER MER MFR MH MIN MISC MM MTD MTL	METER MAINTENANCE MAXIMUM MOTOR CONTROL CENTER MEDIUM DENSITY FIBERBOARD MEDIUM DENSITY OVERLAY MECHANICAL MECHANICAL, ELECTRICAL, PLUMBING MECHANICAL EQUIPMENT ROOM MEZZANINE MANUFACTURER MANHOLE MINIMUM MISCELLANEOUS MILLIMETER MOUNTED METAL	S SA SAFB SAN SCHED SD SECT SF SHR SHT SIM SMS SP SPEC SPKR SPR SQ SST ST
N N/A NC NIC NO NOM NPS	NEWTON NOT APPLICABLE NOISE CRITERIA NOT IN CONTRACT NUMBER NOMINAL NOMINAL PIPE SIZE	STD STL STMS STRL SUSP SYMM
NRC NTS O	NOISE REDUCTION COEFFICIENT NOT TO SCALE	T&G T/ TEL TEMP
OA OC OCEW OD OFCI OFOI	OUTSIDE AIR ON CENTER ON CENTER EACH WAY OUTSIDE DIAMETER/DIMENSION OWNER FURNISHED, CONTRACTOR INSTALLED OWNER FURNISHED, OWNER INSTALLED	TGB THK TP TV TYP
oh oph opng opp	OVER HEAD OPPOSITE HAND OPENING OPPOSITE	u Ul Uon
OXY P PAF	OXYGEN POWER-ACTUATED FASTENER	V VERT VEST VIF
PBD PD PERF PL PLBG PLF PR	PARTICLEBOARD PERIMETER DRAIN	VIF W/ W/O WC WDS WP WT WWR
Q QTY	QUANTITY	
R RA RCP RD RECPT REF REFR REINF REQ REV RM RO	ROOF DRAIN RECEPTACLE REFERENCE REFRIGERATOR	

MARC PHASE 1 OFFICE RENOVATION

600 BROADWAY BLVD STE 200, KANSAS CITY, MO 64105


SA SUPPLY AIR SAFB SOUND ATTENUATING FIRE BLANKET / BATT SAN SANITARY SCHED SCHEDULE STORM DRAIN SECT SECTION SQUARE FEET / FOOT SHOWER SHEET SIMILAR SQUARE METER SHEET METAL SCREW STANDPIPE SPEC SPECIFICATION SPKR SPEAKER SPR SPRINKLER SQUARE STAINLESS STEEL STONE STD STANDARD STL STEEL STMS SELF-TAP SHEET METAL SCREW STRL STRUCTURAL SUSP SUSPENDED SYMM SYMMETRICAL

> TONGUE AND GROOVE TOP OF (SEE OTHER WORD) TELEPHONE OR TELECOM TEMPERATURE TOGGLE BOLT THICKNESS TOILET PARTITION TELEVISION TYPICAL

UNDERWRITERS LABORATORY UNLESS OTHERWISE NOTED

VERT VERTICAL VEST VESTIBULE VIF VERIFY IN FIELD

W/ WITH W/O WITHOUT WC WATER CLOSET WDS WOOD SCREW WP WORK POINT WT WEIGHT WWR WELDED WIRE REINFORCING

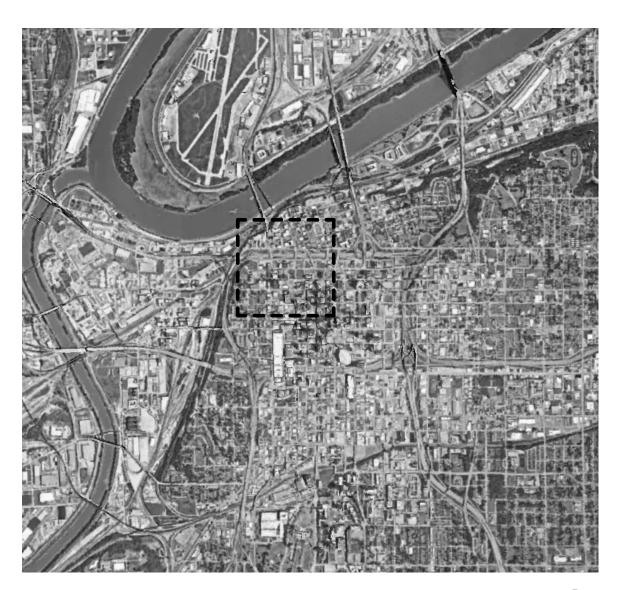

VICINITY MAP N.T.S.

600 BROADWAY BLVD STE 200, KANSAS CITY, MO 64105



LOCATION MAP N.T.S.

LOCATION MAPS

	SHEET LIST		
щ		ORIGINIAL ISSUE	LATEST REVISION
#	SHEET NAME	DATE	DATE
GENER	AL		
G000	COVER	05/31/2022	
G001	GENERAL NOTES, SYMBOLS, AND LEGENDS	05/31/2022	
G005	SPECIFICATIONS	05/31/2022	06/14/2022
G006	SPECIFICATIONS	05/31/2022	06/14/2022
G010		05/31/2022	06/07/2022
G020	WALL TYPES	05/31/2022	06/07/2022
ARCHIT	ECTURE		
AD100	DEMOLITION - LEVEL 03 & 04	05/31/2022	06/07/2022
AD150	RCP DEMOLITION - LEVEL 04	05/31/2022	06/07/2022
A103	FLOOR PLAN - LEVEL 03	05/31/2022	06/07/2022
A104	FLOOR PLAN - LEVEL 04	05/31/2022	06/07/2022
A152	REFLECTED CEILING PLAN - LEVEL 02	05/31/2022	06/14/2022
A153	REFLECTED CEILING PLAN - LEVEL 03	05/31/2022	06/07/2022
A154	REFLECTED CEILING PLAN - LEVEL 04	05/31/2022	06/14/2022
A400	ENLARGED PLANS & INTERIOR ELEVATIONS	05/31/2022	06/07/2022
A570	INTERIOR SECTION DETAILS	05/31/2022	06/07/2022
A600	DOOR & FINISH SCHEDULES	05/31/2022	06/14/2022
A653	FINISH PLAN - LEVEL 03	05/31/2022	06/07/2022
A654	FINISH PLAN - LEVEL 04	05/31/2022	06/07/2022
MECHA			
M001	MECHANICAL LEGEND NOTES	05/31/2022	
M103	LEVEL 03 - HVAC PLAN	05/31/2022	06/07/2022
M104		05/31/2022	06/14/2022
M201	MECHANICAL DETAILS AND SCHEDULES	05/31/2022	06/14/2022
M301 MP102	MECHANICAL SPECIFICATIONS LEVEL 02 - HVAC-PLUMBING PLAN	05/31/2022	06/14/2022
IVIF IUZ		03/31/2022	00/14/2022
PLUMB	NG		
P001	PLUMBING LEGEND AND NOTES	05/31/2022	
P103	LEVEL 03 - DRAIN AND VENT PLAN	05/31/2022	
P104	LEVEL 04 - DRAIN AND VENT PLAN	05/31/2022	
P153	LEVEL 03 - DOMESTIC WATER PLAN	05/31/2022	06/14/2022
P154	LEVEL 04 - DOMESTIC WATER PLAN	05/31/2022	
P201	PLUMBING DETAILS AND SCHEDULES	05/31/2022	
P301	PLUMBING SPECIFICATIONS	05/31/2022	
	•	•	,
ELECT		1	1
ED103	LEVEL 03 - ELECTRICAL DEMOLITION PLAN	05/31/2022	
ED104	LEVEL 04 - ELECTRICAL DEMOLITION PLAN	05/31/2022	
E002		05/31/2022	
E103	LEVEL 03 - POWER PLAN	05/31/2022	0014 410000
E104	LEVEL 04 - POWER PLAN	05/31/2022	06/14/2022
E153	LEVEL 03 - LIGHTING PLAN	05/31/2022	06/07/2022
E154		05/31/2022	06/14/2022
E301		05/31/2022	06/07/2022
E401		05/31/2022	
E402	ELECTRICAL SPECIFICATIONS	05/31/2022	
TECHN	OLOGY		
T001	TECHNOLOGY LEGEND	05/31/2022	06/14/2022
T001	TECHNOLOGY NOTES	05/31/2022	
T103	LEVEL 03 - TECHNOLOGY PLAN	05/31/2022	06/14/2022
T103	LEVEL 04 - TECHNOLOGY PLAN	05/31/2022	06/14/2022
1 1 1 1		30,01/2022	
T201	TECHNOLOGY DETAILS	05/31/2022	
T201 T301	TECHNOLOGY DETAILS TECHNOLOGY SPECIFICATIONS	05/31/2022	

T302 TECHNOLOGY SPECIFICATIONS

05/31/2022



OWNER

MID-AMERICA REGIONAL COUNCIL 600 BROADWAY BLVD STE 200 KANSAS CITY, MO 64105



701 E 63RD STREET SUITE 210 KC MO 64110 | 816.708.1500

ODIMO PROJ. #: 211002

05/31/2022 **BID / PERMIT SET**

ARCHITECT

AMY J. SLATTERY, AIA ODIMO LLC 701 E 63RD STREET #210 KANSAS CITY, MO 64110 816.708.1500 ASLATTERY@ODIMO.US

MEP ENGINEERING

ATTN: BRAD LEWIS BRANCHPATTERN, INC. 1508 GRAND BOULEVARD KANSAS CITY, MO 64108 816.531.2121 BLEWIS@BRANCHPATTERN.COM

01 02 03	04 05 06	07 08 09	10 11 12	13 14 15
DIVISION 01 – GENERAL REQUIREMENTS	013300 - SUBMITTAL PROCEDURES	5. Mounting System A. Basis of Design: CRL Fixed Panel Deep U-Channel	A. Color: To be selected by Architect from manufacturer's standard range. B. Application: Joints between plumbing fixtures and adjoining walls, floors, and counters in Kitchenette space.	 Lock and latches, general: A. Provide operating devices that do not require tight grasping, pinching, or twisting of the wrist and that operate with a force of not more than 5 lbf
K 011000 - SUMMARY 1. Project Identification: MARC Phase 1 Office Renovation	 Submittal Schedule: Submit a list of submittals, arranged in chronological order by dates required by construction schedule. Include time required for review, ordering, manufacturing, fabrication, and delivery when establishing dates. Include additional time required for making required for review, ordering, manufacturing, fabrication, and delivery when establishing dates. Include additional time required for making 	B. Location: Recessed in GWB partial height wall, bottom and sides of panel.C. Corners: Mitered.	6. Type - General Purpose Interior Sealant - Acrylic Emulsion Latex: Water-based; ASTM C834, single component, non-staining, non-bleeding, non- sagging; not intended for exterior use.	B. Latches and Locks for Means of Egress Doors: Comply with NFPA 101. Latches shall not require more than 15 lbf (67 N) to release the latch.
A. Project Location: 600 Broadway Blvd, Kansas City, MO 64105 B. Owner: Mid-America Regional Council	corrections or revisions to submittals noted by Architect and additional time for handling and reviewing submittals required by those corrections.	D. Finish: Satin Nickel E. Width: 1/2"	A. Color: To be selected by Architect from manufacturer's standard range. B. Grade: ASTM C834; Grade - NF.	Locks shall not require use of a key, tool, or special knowledge for operation C. Electrified Locking Devices: BHMA A156.25.
a. Owner's Representative: • Carol Gonzales, Director of Finance and Administration (MARC)	 Submittal Information: Include the following information in each submittal: A. Project name. B. Date. 	F. Pocket Depth: 3/4"	a. Applications: Other interior joints for which no other type of sealant is indicated.	D. Strikes: Manufacturer's standard strike with strike box for each latchbolt or lock bolt, with curved lip extended to protect frame, finished to match door hardware set, and as follows:
Contact Email: cgonzales@MARC.ORG Eric Winebrenner, Public Safety Program Director (MARC) Contact Emails extracted environment OMAPC OPC	 Date. C. Unique submittal number, including revision identifier. Include Specification Section number with sequential alphanumeric identifier; and alphanumeric suffix for resubmittals. 	1. Lumber: DOC PS 20 and applicable rules of grading agencies indicated. If no grading agency is indicated, provide lumber that complies with the	DIVISION 08 - HARDWARE	 Strikes for Mortise Locks and Latches: BHMA A156.13. Strikes for Interconnected Locks and Latches: BHMA A156.12. Strikes for Antificar Deadlesize Diabates Diabates 2010/0000000000000000000000000000000000
1. Contact Email: ewinebrenner@MARC.ORG C. Architect: Odimo, LLC a. Architect's Representative: Ashley Perrin	D. Options: Identify options requiring selection by Architect. E. Deviations and Additional Information: On each submittal, clearly indicate deviations from requirements in the Contract Documents,	 applicable rules of any rules-writing agency certified by the ALSC Board of Review. Provide lumber graded by an agency certified by the ALSC Board of Review to inspect and grade lumber under the rules indicated. 2. Factory mark each piece of lumber with grade stamp of grading agency. 	1. Required Submittals: A. Product Data	 Strikes for Auxiliary Deadlocks: BHMA A156.5. Mechanical locks and latches, general: A. Lock Functions: Function numbers and descriptions indicated in door hardware sets comply with the following:
Contact Email: aperin@odimo.us Contact Number: 816-708-1506	 Bevalues and Additional momination: On each submittal, oreany including minor variations and limitations. Electronic Submittals: Prepare submittals as PDF package, incorporating complete information into each PDF file. Name PDF file with 	 Factory mark each piece of further with grade stamp of grading agency. For exposed lumber indicated to receive a stained or natural finish, mark grade stamp on end or back of each piece or omit grade stamp and provide certificates of grade compliance issued by grading agency. 	 A. Product Data B. Shop Drawings 2. Manufacturers: Subject to compliance with requirements, provide products by one of the following: 	 A. Lock Functions: Function numbers and descriptions indicated in door naroware sets comply with the following. 1. Mortise Locks: ANSI/BHMA A156.2 Series 1000, Grade 1. 2. Cylindrical Locks: ANSI/BHMA A156.2 Series 4000, Grade 1.
J D. MEP Engineer: BranchPattern a. MEP Representative: Mark Stainbrook	 submittal number. Prepare and submittals required by individual Specification Sections. Types of submittals are indicated in individual Specification 	 Dress lumber, S4S, unless otherwise indicated. Maximum Moisture Content of Lumber: 19 percent unless otherwise indicated. 	 A. Ceco Door; ASSA ABLOY. B. Curries Company; ASSA ABLOY. 	 Complexity of the string requirements for length of bolts required for labeled fire doors.
Contact Email: mark.s@branchpattern.com Contact Number: 913-254-3426	Sections A. Email: Prepare submittals as PDF package, and transmit to Architect by sending via email. Include PDF transmittal form. Include	 General: Provide miscellaneous lumber indicated and lumber for support or attachment of other construction, including the following blocking & nailers. Dimension Lumber Items: Construction or No. 2 grade lumber of any species. 		 B. Dustproof Strikes: BHMA A156.16, Grade 1. C. Automatic and Self-Latching Flush Bolts: BHMA A156.3, Grade 1 unless Grade 2 is indicated; designed for mortising into door edge.
 Type of Contract: Project will be constructed under a single prime contract. Limits on Use of Site: Confine construction operations to work area as indicated within the Drawings. Coordinate access to adjacent 	information in email subject line as requested by Architect. 5. Processing Time: Allow time for submittal review, including time for resubmittals, as follows. Time for review shall commence on		4. Fire-Rated Door Assemblies: Assemblies complying with NFPA 80 that are listed and labeled by a qualified testing agency acceptable to authorities having jurisdiction for fire-protection ratings indicated on Drawings, based on testing at positive pressure according to NFPA 252 or	7. Lock cylinders: A. Standard Lock Cylinders: BHMA A156.5 Grade 1.
spaces, if required to complete work as indicated in the Drawings, with the Owner and building management company. 4. Driveways, Walkways, and Entrances: Keep driveways, parking garage, loading areas, and entrances serving premises clear and	Architect's receipt of submittal. No extension of the Contract Time will be authorized because of failure to transmit submittals enough in advance of the Work to permit processing, including resubmittals.	B. Eastern softwoods, No. 2 Common grade; NELMA. C. Northern species, No. 2 Common grade; NLGA.	UL 10C. 5. Heavy-Duty Doors and Frames: SDI A250.8, Level 2; SDI A250.4, Level B.	B. Cylinders: Interchangeable core, manufacturer's standard tumbler type, constructed from brass or bronze, stainless steel, or nickel silver, comply with schedule and the following:
available to Owner, Owner's employees, other building tenants, and emergency vehicles at all times. Do not use these areas for parking or for storage of materials.	1. Initial Review: Allow 7 days for initial review of each submittal. Allow additional time if coordination with subsequent submittals is required. Architect will advise Contractor when a submittal being processed must be delayed for coordination.	D. Western woods, Construction or No. 2 Common grade; WCLIB or WWPA. E. Screws for Fastening to Metal Framing: ASTM C1002, length as recommended by screw manufacturer for material being fastened.	a. Doors:Type: As indicated in the Door and Frame Schedule.	 Number of Pins: to match existing building systems. Mortise Type: Threaded cylinders with rings and straight- or clover-type cam.
5. Condition of Existing Building: Maintain portions of existing building affected by construction operations in a weathertight condition throughout construction period. Repair damage caused by construction operations.	 Resubmittal Review: Allow 7 days for review of each resubmittal. Contractor to review each submittal and check for coordination with other Work of the Contract and for compliance with the Contract 	064116 - PLASTIC-LAMINATE-FACED ARCHITECTURAL CABINETS	 Thickness: 1-3/4 inches. Face: Uncoated steel sheet, minimum thickness of 0.042 inch. 	C. Construction Keying: Comply with the following: 1. Construction Master Keys: Provide cylinders with feature that permits voiding of construction keys without cylinder removal. Provide 10
6. Condition of Existing Grounds: Maintain portions of existing grounds, landscaping, and hardscaping affected by construction operations throughout construction period. Repair damage caused by construction operations.	Documents. Note corrections and field dimensions. Mark with approval stamp before submitting to Architect. 013516 - ALTERATION PROJECT PROCEDURES	1. Required Submittals: A. Product Data	 Edge Construction: Model 1, Full Flush. Core: Manufacturer's standard. 	construction master keys. 2. Construction Cores: Provide construction cores that are replaceable by permanent cores. Provide 10 construction master keys.
 7. Items to be Owner Provided, Owner Installed (OPOI) and Owner Provided, Contractor Installed (OPCI) have been noted within the drawings. 9. Owner Limited Occurrency of Completed Access of Construction, Owner Provided, Contractor Installed (OPCI) have been noted within the 	 Prior to start of alteration work, Contractor shall conduct conference at project site. Attendees shall include Owner's Representative, Architect, and Contractor. 	 B. Shop Drawings Quality Standard: Unless otherwise indicated, comply with the "Architectural Woodwork Standards" for grades of woodwork indicated for construction, finishes installation and they requiremente 	 Fire-Rated Core: Manufacturer's standard core for fire-rated, when indicated on the Drawings. Color: Paint to match other existing doors on level installed. 	 a. Replace construction cores with permanent cores as directed by Owner. b. Furnish permanent cores to Owner for installation. D. Manufacturer: Same manufacturer as for locks and latches.
8. Owner Limited Occupancy of Completed Areas of Construction: Owner reserves the right to occupy and to place and install equipment in completed portions of the Work, prior to Substantial Completion of the Work, provided such occupancy does not interfere with completion of the Work. Such placement of equipment and limited occupancy shall not constitute acceptance of the total Work.	 Coordination meetings shall be held weekly to review progress. Storage and handling of salvaged materials: 	 finishes, installation, and other requirements. Fabricator Qualifications: Company specializing in fabricating the products specified in this section with minimum five years of documented experience. SCOPE OF THE CASEWORK SUPPLIER/INSTALLER: 	 b. Frames: Materials: Uncoated steel sheet, minimum thickness of 0.053 inch. Frames: Fabricated from same thickness material as adjacent door frame. 	 Manufacturer. Same manufacturer as for locks and lateries. Keying: A. Door P302 shall be keyed to the existing master Best key system. Keying Schedule must be approved by the Owner prior to ordering any locks.
 Comply with restrictions on construction operations. Comply with limitations on use of public streets, work on public streets, rights of way, and other requirements of authorities having 	 A. Salvaged Materials: a. Clean loose dirt and debris from salvaged items unless more extensive cleaning is indicated. 	 A. Casework and accessories: Furnish to building, and unpack and/or uncrate, set in place, level and fasten all specified casework and equipment. B. Clean up: Remove debris, dirt, and rubbish accumulated as a result of delivery of this equipment and leave premises broom clean and orderly. 	 Construction: Face Welded Color: Paint to match other existing frames on level installed. 	Door P302 shall be keyed to the existing master best key system. Keying Schedule must be approved by the Owner phon to ordening any locks. Door P310 is to be keyed independently from overall building / university standard cylinders. Provide Construction cores. B. Key all locks separately, or alike, as directed by the Owner's Representative and Architect.
jurisdiction. 11. On-Site Work Hours: Limit work in the existing building to standard work hours, excluding nights and weekends, to be coordinated as	 b. Store items in a secure area until delivery to Owner. c. Transport items to Owner's storage area on-site. 	Americans With Disabilities Act Requirements: The following special requirements shall be met, where specifically indicated on architectural plans		C. Provide keys as follows: 1. Change Keys: 2 per lock.
necessary by building management company and owner. 12. Existing Utility Interruptions: Do not interrupt utilities serving facilities occupied by Owner or others unless permitted under the following	d. Protect items from damage during transport and storage. B. Salvaged Materials for Reinstallation:	C. Confirm coordination with appliances. D. Fillers, scribes, access holes: Provide all necessary fillers and scribes for a complete job.	A. Jamb Anchors: a. Type: Anchors of minimum size and type required by applicable door and frame standard, and suitable for performance level indicated.	 Master Keys: 6 required (per system). Identification: Stamp all (master-type) keys with the following:
 conditions and then only after providing temporary utility services according to requirements indicated: A. Notify Owner not less than two days in advance of proposed utility interruptions. 	a. Repair and clean items for reuse as indicated. b. Protect items from damage during transport and storage.	 E. Provide all access holes in cabinets and countertops required by mechanical, electrical, and HVAC contractors. 5. Countertops: 	 b. Quantity: Minimum of three anchors per jamb, with one additional anchor for frames with no floor anchor. Provide one additional anchor for each 24 inches of frame height above 7 feet. 	a. Do Not Duplicate. b. Key change number (all keys).
 H B. Obtain Owner's written permission before proceeding with utility interruptions. 13. Noise, Vibration, Dust, and Odors: Coordinate operations that may result in high levels of noise and vibration, dust, odors, or other 	c. Reinstall items in locations indicated. Comply with installation requirements for new materials and equipment unless otherwise indicated. Provide connections, supports, and miscellaneous materials to make items functional for use indicated.	A. Finish - Exposed Exterior Surfaces: Decorative laminate a. Basis of Design: As Indicated on Drawings	c. Postinstalled Expansion Anchor: Minimum 3/8-inch- diameter bolts with expansion shields or inserts, with manufacturer's standard pipe spacer.	9.Electric Strikes: A. Standard: BHMA A156.31 Grade 1.
disruption to Owner occupancy with Owner. A. Notify Owner not less than two days in advance of proposed disruptive operations.	C. Existing Materials to Remain: Protect construction indicated to remain against damage and soiling from construction work. Where permitted by Architect, items may be dismantled and taken to a suitable, protected storage location during construction work and	B. Finish - Solid Surface a. Basis of Design: As Indicated on Drawings	B. Floor Anchors: Provide floor anchors for each jamb and mullion that extends to floor. C. Floor Anchors for Concrete Slabs with Underlayment: Adjustable-type anchors with extension clips, allowing not less than 2-inch height	B. General: Use fail-secure electric strikes with fire-rated devices. 10.Operating trim:
 B. Obtain Owner's written permission before proceeding with disruptive operations. 14. Smoking and Controlled Substance Restrictions: Use of tobacco products, alcoholic beverages, and other controlled substances within 	reinstalled in their original locations after alteration and other construction work in the vicinity is complete. D. Storage: Catalog and store items within a weathertight enclosure where they are protected from moisture, weather, condensation, and	C. Backsplace: Only where indicated on Drawings D. Composition: Glass and Porcalain aggregate, resin, and color pigments formed into flat slabs	adjustment. Terminate bottom of frames at top of underlayment. D. Material: ASTM A 879/A 879M, Commercial Steel (CS), 04Z coating designation; mill phosphatized.	A. Standard: BHMA A156.6 [and as illustrated on Drawings]. B. Materials: Fabricate from brass bronze or stainless steel, unless otherwise indicated.
the existing building is not permitted. 15. The Contractor shall furnish all labor, materials, tools, equipment necessary for, and incidental to, construction of this project as	freezing temperatures. 4. Protect persons, motor vehicles, surrounding surfaces of building, building site, plants, and surrounding buildings from harm resulting from alteration work		 Inserts, Bolts, and Fasteners: Hot-dip galvanized according to ASTM A153/A153M. A. Cold-Rolled Steel Sheet: ASTM A1008/A1008M, Commercial Steel (CS), Type B; suitable for exposed applications. 	12. Protective trim units: A. Size: 1-1/2 inches (38 mm) less than door width on push side and 1/2 inch (13 mm) less than door width on pull side, by height specified in door
indicated on Drawings and specified herein. 16. Work shall include everything requisite and necessary to finish work properly, notwithstanding that every item of labor or materials or	alteration work. 5. Protect existing materials with temporary protections and construction. Do not remove existing materials unless otherwise indicated.	A. Finish - Exposed Exterior Surfaces: Decorative laminate, As Indicated on Drawings B. Finish - Exposed Interior Surfaces: Same as exterior.	B. Hot-Rolled Steel Sheet: ASTM A1011/A1011M, Commercial Steel (CS), Type B; free of scale, pitting, or surface defects; pickled and oiled. C. Metallic-Coated Steel Sheet: ASTM A653/A653M, Commercial Steel (CS), Type B.	hardware sets. B. Fasteners: Manufacturer's standard machine or self-tapping screws.
accessories required to make project complete may not be specifically mentioned.	 Comply with each product manufacturer's written instructions for protections and precautions. Protect against adverse effects of products and procedures on people and adjacent materials, components, and vegetation. Notify Owner, Architect, authorities having jurisdiction, and entities owning or controlling wires, conduits, pipes, and other services 	C. Finish - Concealed Surfaces: Melamine at laminate casewor a. Color: White	 Hollow-Metal Frames: Fabricate in one piece except where handling and shipping limitations require multiple sections. Where frames are fabricated in sections, provide alignment plates or angles at each joint, fabricated of metal of same or greater thickness as frames. 	C. Metal Protective Trim Units: BHMA A156.6; beveled top and 2 sides; fabricated from [material indicated in door hardware sets. 13. Stops and holders:
G 012200 - UNIT PRICES 1. Unit prices include all necessary material, plus cost for delivery, installation, insurance, applicable taxes, overhead, and profit.	 Notify Owner, Architect, additionals having jurisdiction, and endues owning or controlling whes, conduits, pipes, and other services affected by alteration work before commencing operations. Bisconnect and cap pipes and services as required by authorities having jurisdiction, as required for alteration work. 	D. Door and Drawer Front Edge Profiles: Square edge with thin applied band018" minimum. a. Color to match exposed exterior surface laminate.	A. Fire-Rated Openings: Install frames according to NFPA 80 10. Hollow-Metal Doors: Fit and adjust hollow-metal doors accurately in frames, within clearances specified below.	A. Stops and Bumpers: BHMA A156.16 Grade 1 unless Grade 2 is indicated 1. Provide floor stops for doors unless wall or other type stops are scheduled or indicated. Do not mount floor stops where they will impede
 Owner reserves the right to reject Contractor's measurement of work-in-place that involves use of established unit prices and to have this work measured, at Owner's expense, by an independent surveyor acceptable to Contractor. Schedule of Unit Prices: 	 Disconnect and cap pipes and services as required by autinities having jurisdiction, as required to alteration work. Maintain existing services unless otherwise indicated; keep in service, and protect against damage during operations. Provide temporary services during interruptions to existing utilities. 	E. Casework Construction Type: Type A - Frameless. F. Custom Grade: Doors, drawer fronts and false fronts.	A. Non-Fire-Rated Steel Doors: Comply with ANSI/SDI A250.8. B. Fire-Rated Doors: Install doors with clearances according to NFPA 80.	traffic. Where floor or wall stops are not appropriate, provide overhead holders. B. Mechanical Door Holders: BHMA A156.16 Grade 1 unless Grade 2 is indicated
 Schedule of Unit Prices: B. Unit Price No. 1: Cutting and patching gypsum board. 1. Description: Cutting of new or existing gypsum board up to 1 inches thick, removal, and subsequent patching of gypsum, in 	 Comply with NFPA 241 requirements unless otherwise indicated. Record existing work before each procedure (preconstruction), and record progress during the work. Use digital preconstruction 	G. Adjustable Shelf Loading: 50 lbs. per sq. ft. a. Deflection: L/144. H. Cabinet Style: Flush overlay.	 C. Smoke-Control Doors: Install doors according to NFPA 105. 11. Door Silencers: Except on weather-stripped frames, drill stops to receive door silencers as follows. Keep holes clear during construction. A. Single-Door Frames: Drill stop in strike jamb to receive three door silencers. 	C. Combination Floor and Wall Stops and Holders: BHMA A156.8 Grade 1 D. Combination Overhead Stops and Holders: BHMA A156.8 Grade 1 E. Electrometric Deer Holders: DHMA A156 15 (Listed under Ceteorers C in DHMA): "Certified Deedvet Directors "1
accordance with Section 092900 "Gypsum Board." 2. Unit of Measurement: 5 square foot of gypsum board removed.	documentation photographs.	I. Cabinet Doors and Drawer Fronts: Flush style. J. Drawer Construction Technique: Dovetail joints.	 B. Double-Door Frames: Drill stop in head jamb to receive two door silencers. Hardware Preparation: Factory prepare hollow-metal frames to receive templated mortised hardware, and electrical wiring; include cutouts, 	 E. Electromagnetic Door Holders: BHMA A156.15. [Listed under Category C in BHMA's "Certified Product Directory."] 1. Coordinate with fire detectors and interface with fire alarm system for labeled fire door assemblies. F. Silencers for Metal Door Frames: BHMA A156.16, Grade 1; neoprene or rubber, minimum diameter 1/2 inch (13 mm); fabricated for drilled-in
C. Unit Price No. 2: Installing Joint Sealants. 1. Description: Installation of joint sealants in accordance with Section 079200 "Joint Sealants."	DIVISION 02 – DEMOLITION	7. Hardware: a. Finish:	reinforcement, mortising, drilling, and tapping according to SDI A250.6, the Door Hardware Schedule, and templates. 13. Reinforce frames to receive nontemplated, mortised, and surface-mounted door hardware.	application to frame. 14. Door gasketing:
 Unit of Measurement: 1 linear feet of sealant. D. Unit Price No. 3: Installing Acoustical Joint Sealants. 	024119 - SELECTIVE DEMOLITION 1. Unless otherwise indicated, demolition waste becomes property of Contractor.	Exposed - Satin Nickel	14. Comply with BHMA A156.115 for preparing hollow-metal frames for hardware. 15. GLAZING	A. Standard: BHMA A156.22. [Listed under Category J in BHMA's "Certified Product Directory."] B. General: Provide continuous weather-strip gasketing on exterior doors and provide smoke, light, or sound gasketing on interior doors where
 F 1. Description: Installation of acoustical joint sealants in accordance with Section 079200 "Joint Sealants." 2. Unit of Measurement: 1 linear feet of sealant. 	Owner will occupy portions of building immediately adjacent to selective demolition area. Conduct selective demolition so Owner's operations will not be disrupted.	b. Adjustable Shelf Supports: Standard side-mounted system using multiple holes for pin supports and coordinated self rests, polished chrome or satin chrome finish, for nominal 1 inch spacing adjustments.	A. Provide glazing when indicated in the Drawings B. Glazing type: Tempered	indicated or scheduled. Provide noncorrosive fasteners for exterior applications and elsewhere as indicated. 1. Perimeter Gasketing: Apply to head and jamb, forming seal between door and frame.
012300 - ALTERNATES	 Conditions existing at time of inspection for bidding purpose will be maintained by Owner as far as practical. Notify Architect of discrepancies between existing conditions and Drawings before proceeding with selective demolition. 	a. Product: 346ANO manufactured by Knape and Vogt. c. Door Pull: 5" EUROPA TAB PULL	C. Thickness: 1/4", or min. as required by Manufacturer D. Coordinated with door and beads.	 Meeting Stile Gasketing: Fasten to meeting stiles, forming seal when doors are closed. Door Bottoms: Apply to bottom of door, forming seal with threshold when door is closed.
 Coordination: Revise or adjust affected adjacent work as necessary to completely integrate work of the alternate into Project. A. Include as part of each alternate, miscellaneous devices, accessory objects, and similar items incidental to or required for a complete 	 Hazardous Materials: It is not expected that hazardous materials will be encountered in the Work. A. Hazardous materials will be removed by Owner before start of the Work. 	a. Location: As Indicated on the Drawings b. Basis of Design: Top Knobs	E. Color: Clear.	C. Air Leakage: Not to exceed 0.50 cfm per foot (0.000774 cu. m/s per m) of crack length for gasketing other than for smoke control, as tested according to ASTM E 283.
installation whether or not indicated as part of alternate. B. Execute accepted alternates under the same conditions as other work of the Contract.	 B. If suspected hazardous materials are encountered, do not disturb; immediately notify Architect and Owner. Hazardous materials will be removed by Owner under a separate contract. I with Convise. Maintain evicting, within a separate contract. 	d. Drawer Pulls: 5" EUROPA TAB PULL	081416 - FLUSH WOOD DOORS 1. Required Submittals:	D. Smoke-Labeled Gasketing: Assemblies complying with NFPA 105 that are listed and labeled by a testing and inspecting agency acceptable to authorities having jurisdiction, for smoke-control ratings indicated, based on testing according to UL 1784.
C. Reference Drawings and associated Specification Sections for further information. 2. Schedule of Alternates:	 Utility Service: Maintain existing utilities indicated to remain in service and protect them against damage during selective demolition operations. Temporary Protection: Provide temporary barricades and other protection required to prevent injury to people and damage to adjacent 	a. Location: As Indicated on the Drawings b. Basis of Design: Top Knobs	A. Product Data B. Shop Drawings	 Provide smoke-labeled gasketing on 20-minute-rated doors and on smoke-labeled doors. E. Fire-Labeled Gasketing: Assemblies complying with NFPA 80 that are listed and labeled by a testing and inspecting agency acceptable to
A. Alternate No. 1: Rm 428 - Monitor Wall a. Base Bid: Provide walls to deck (A3 wall type) surrounding Rm 427 Secure Server Room. Remove ceiling tile, protect, adjust grid,	 remporary Protection. Provide temporary barncades and other protection required to prevent injury to people and damage to adjacent buildings and facilities to remain. 8. General: Demolish and remove existing construction only to the extent required by new construction and as indicated. Use methods 	c. Finish: Satin Nickel e. Drawer Slides:	C. Manufacturers: Subject to compliance with requirements, provide products by one of the following: a. VT Industries Inc.	authorities having jurisdiction, for fire ratings indicated, based on testing according to NFPA 252, UBC Standard 7-2 F. Sound-Rated Gasketing: Assemblies that are listed and labeled by a testing and inspecting agency, for sound ratings indicated, based on testing
 and reinstall tile (altering as needed) at full perimeter, interior and exterior, of new room. b. Alternate: In lieu of Base Bide, provide wall (A3 wall type) with integrated monitor mount reinforcement, door, door hardware, and frame. Remove ceiling tile, protect, adjust grid, and reinstall tile (altering as needed) at full extent of new wall. Walls surrouding 	 required to complete the Work within limitations of governing regulations. Existing Items to Remain: Protect construction indicated to remain against damage and soiling during selective demolition. When 	a. Type: Full extension with overtravel. b. Static Load Capacity: Heavy Duty grade. c. Mounting: Side mounted.	b. Masonite Architectural c. Eggers Industries D. Thickness: 1 3/4"	according to ASTM E 1408. G. Replaceable Seal Strips: Provide only those units where resilient or flexible seal strips are easily replaceable and readily available from stocks
adjacent rooms will only go to bottomside of existing ceiling tile. B. Alternate No. 2: Rm 407 - Worksurface w/ Shelving	permitted by Architect, items may be removed to a suitable, protected storage location during selective demolition and cleaned and reinstalled in their original locations after selective demolition operations are complete.	d. Stops: Integral type. e. Features: Provide self closing/stay closed type.	E. Factory Finished F. VENEER-FACED DOORS FOR OPAQUE FINISH	maintained by manufacturer. H. Gasketing Materials: ASTM D 2000 and AAMA 701/702. 16. Miscellaneous door hardware:
 a. Base Bid: No Scope b. Alternate: Provide plastic laminate countertop, counter supports, aluminum legs, and wire shelving. Secure through existing wall 	10. Clean adjacent structures and improvements of dust, dirt, and debris caused by selective demolition operations. Return adjacent areas to condition existing before selective demolition operations began.	 f. Manufacturers: Accuride International, Inc; 3832SC: www.accuride.com. 	a. Performance Grade: ANSI/WDMA I.S. 1A Heavy Duty. b. Interior Solid-Core Doors:	A. Boxed Power Supplies: Modular unit in NEMA ICS 6, Type 4 enclosure; filtered and regulated; voltage rating and type matching requirements of door hardware served; and listed and labeled for use with fire alarm systems.
finish. Refer to plans for additional information. C. Alternate No. 3: Rm 313 - New High-Density Shelving	DIVISION 4 – MASONRY	 Grass America Inc: www.grassusa.com. Knape & Vogt Manufacturing Company; 8417: www.knapeandvogt.com. 	Grade: Premium. Finish: Prepared for paint. To be Field Painted.	B. Auxiliary Hardware: BHMA A156.16, Grade 1. 17. Finishes: As noted below. Finishes shall conform to the quality of finish including thickness of plating or coating (if any), composition, hardness and
a. Base Bid: No Scope b. Alternate: Demolish existing base cabinets, countertop, and upper cabinets in their entirety. Cap plumbing as needed - refer to	042000 - UNIT MASONRY	 f. Drawer Slides for File-Sized Drawers: Clear zinc finish, ball bearings separating tracks, full extension, 200 pound static load capacity. a. Product: "8800" manufactured by Knape and Vogt; "3640A" manufactured by Accuride; or 	 Color: Paint to match other existing doors on level installed. c. Exposed Vertical Edges: Same species as faces or a compatible species - edge Type A. 	other qualities complying with manufacturer's standards, but in no case less than the standards established by ANSI A156.18 (BHMA 1301) or Federal Specifications FF-H-111C as applicable.
MEP. Confirm blocking in wall as needed, and patch/repair existing GWB. Paint wall corner to corner. Provide high-density shelving.	1. Section Includes: A. Breathable Brick Sealer	b. approved equivalent. g. Hinges: European style concealed self-closing type.	d. Core: Structural composite lumber. e. Construction: Five plies. Stiles and rails are bonded to core, then entire unit is abrasive planed before veneering. Faces are bonded to core	1. Notify the Architect if doors require alternate hardware or fixtures due to existing conditions.
a. Base Bid: No Scope	2. Required Submittals: A. Product Data	a. Finish: Brushed Satin Nickel b. Opening: 130-degree minimum.	using a hot press. f. Confirm coordination with Hollow Metal Frames.	HARDWARE SET: 01, PROVIDE EACH SGL DOOR(S) WITH THE FOLLOWING:
b. Alternate:Provide the additional walls (A3b wall type) on Level 02 atop existing walls as indicated in the Drawings. Paint wall in their entirety as indicated on the Drawings. Demo existing ceiling in offices where new walls extend to deck to expose wood	3. Quality Assurance: A. Mockups:	c. Manufacturers: • Grass America Inc: www.grassusa.com.	G. LIGHT FRAMES a. Wood Beads for Light Openings in Wood Doors: Provide manufacturer's standard wood beads unless otherwise indicated.	3 EA HINGE 5BB1HW 652 IVE 1 EA WALL STOP WS406/407CCV 626 IVE
structure above. E. Alternaterin, 5: Phased Construction Process a. Base Bid: Construction to occur on Level 02, Level 03, and Level 04 to occur concurrently.	 a. Testing: Clean an area, approx 16sf, for each type of masonry and surface condition. Test cleaners & sealers for possible adverse reactions. Do not test cleaners and methods known to have deleterious effect. Allow a waiting period of not less than 3 days after completion of sample cleaning to permit a study for negative reactions. 	 Hafele; www.hafele.com Hardware Resources: www.hardwareresources.com. Mull Cleate: Erspek starts for stud wall partitions, with lower cleat featoned to wall and upper cleat featoned to milluer/. 	 b. Wood Species: Species compatible with door faces. c. At locations indicated in the Drawing. d. Brofile: Eluch contemporter bandometers 	4 EA SILENCER 608-RKW GRAY ROC 1 EA MORTISE LOCK L9050L 06 626 SCH
b. Alternate: Provide resulting cost and schedule impact if work on Level 04 were to occur prior to work on Level 03, in order to	 Allow a waiting period of not less than 3 days after completion of sample cleaning to permit a study for negative reactions. Cleaning Appearance Standard: Cleaned surfaces are to have a uniform appearance as viewed from 20 feet away by Architect. Proceed with cleaning in an orderly manner. Ensure that dirty residues and rinse water do not wash over dry, cleaned surfaces. 	 d. Wall Cleats: French cleats for stud wall partitions, with lower cleat fastened to wall and upper cleat fastened to millwork. e. Concealed panel clips: white plastic male-female fitting; e. Product: Hafele Keky Push in Fitting or approved equal: white plastic or finish to match binger. 	d. Profile: Flush rectangular beads. e. Heavy Duty for secure install of laminated glazing.	1 EA MORTISE CYLINDER AS REQ'D/VERIFY KEYWAY 626
provide the owner the opportunity to move floors and remain working in the building during construction. Assume receipt of Level 04 TCO to occur prior to start of work on Level 03. Minor work can continue on Level 04 following transition of floors, but work is to be kept to a minimum.	 Proceed with cleaning in an orderly manner. Ensure that dirty residues and tinse water do not wash over dry, cleaned surfaces. Prepare surface per Manufacturer Recommendation: A. Brush and vaccuum loose debris as necessary. Provide Manufacturer recommended masonry cleaner. 	 Product: Hafele Keku Push-in Fitting or approved equal; white plastic or finish to match hinges. 8. High Pressure Decorative Laminate (HPDL): NEMA LD 3, types as recommended for specific applications. 9. Provide specific types as follows: 	H. GLAZING a. Safety Glazing to be clear laminated glass w/ two-plys of ultra clear heat-strengthened float glass b. Thickness: 6mm per ply, min.	HARDWARE SET: 02, PROVIDE EA SGL OF DOORS WITH THE FOLLOWING: <u>QTY</u> <u>DESCRIPTION</u> <u>CATALOG NUMBER</u> <u>FINISH</u> <u>MFR</u> 2 EA HINCE
012500 - SUBSTITUTION PROCEDURES	 B. Confirm surfaces are completely dry prior to application of sealer. 7. Interior Masonry Dustproofer 	 Provide specific types as follows: A. Horizontal Surfaces: HGS, 0.048 inch nominal thickness, through color, colors as scheduled, finish as scheduled. B. Vertical Surfaces: VGS, 0.028 inch nominal thickness, through color, colors as indicated, finish as scheduled. 	c. Interlayer Thickness: .06 in d. Color: Clear	3 EA HINGE 5BB1HW 652 IVE 1 EA WALL STOP WS406/407CCV 626 IVE 3 EA SILENCER 608-RKW GRAY ROC
 The specifications herein outline the Basis of Design, where appropriate. Requests for substituttions, alternate manufacturers, or proposed equal products will be considered, subject to compliance with specification requirements and Architects approval. 	 A. Provide product to prevent further dusting of exposed interior masonry and provide water resistance to the applied surface. a. Manufacturer: Basis of Design - Prosoco Weather Seal Interior Masonry Dustproofer 	 D. Ventical Surfaces. VGS, 0.020 inch nominal thickness, through color, colors as indicated, millin as scrieduled. C. Laminate Backer: BKL, 0.020 inch nominal thickness, undecorated; for application to concealed backside of panels faced with high pressure decorative laminate. 	 color. Clear e. Safety glazing labeling: where indicated, permanently mark glazing w/ certification label of the sgcc. Label shall indicate manufacturer's name type of glss, thickness, and safety glazing standard w/ which glass complies. 	
 C 2. Submit (1) copy for each request for consideration via email to the Architect. Identify product, fabrication, or installation method to be replaced. 	b. Equal substitutions will be considered. B. VOC Content: <100g/L	10. Adhesives: Chemical resistant waterproof adhesive as recommended by manufacturer of materials being joined. 11. Joint Sealant: Mildew-resistant silicone sealant, clear.	087100 - DOOR HARDWARE	HARDWARE SET: 03, PROVIDE EA SGL OF DOORS WITH THE FOLLOWING:
 A. Request is to include the following: specification number, why specified product, fabrication, or installation method cannot be provided, product data for proposed substitution, samples, cost information, schedule adjustments, etc. Also include Contractor's 	C. Finish: Clear D. Sheen: Flat	A. Confirm compliance with countertop manufacturer recommendation. 12. Provide sealant and caulking as necessary for solid surface countertop.	1. Required Submittals: A. Product Data	QTY DESCRIPTION CATALOG NUMBER FINISH MFR 1 EA ELEC. HINGE 5BB1 TW8 652 IVE
waiver of rights to additional payment or time that may subsequently become necessary because of failure of proposed substitution to produce indicated results.		A. Basis of Design: Standard manufacturer recommendation.	B. Door Hardware Sets a. Same Scheduling sequence as documents	2 EA HINGE 5BB1 HW 652 IVE 1 EA ELEC. LOCKSET L9092LEU 06N 626 SCH
B. If necessary, the Architect will request additional information or documentation for evaluation within seven days of receipt. Architect will notify Contractor of acceptance or rejection of proposed substitution within fifteen days of receipt, or seven 7 days of receipt of		DIVISION 07 - THERMAL AND MOISTURE PROTECTION	 Door Hardware: A. Provide manufacturer's standard products meeting the design intent of this Specification, free of imperfections affecting appearance or 	1 EA MORTISE CYLINDER AS REQ'D/VERIFY KEYWAY 626 EA WIRE HARNESS CON X LENGTH REQ'D
additional information or documentation, whatever is later. a. Form of Acceptance: Change Order, Construction Change Directive, or Architect's Supplemental Instructions for minor changes in	060660 PLASTICS FABRICATIONS 1. Section includes:	079200 - JOINT SEALANTS 1. Required Submittals:	serviceability. B. Accessibility Requirements: Where handles, pulls, latches, locks, and other operating devices are indicated to comply with accessibility	1 EA WALL STOP WS406/407CCV 626 IVE 1 EA DOOR CONTACT 7766 - SCH
	A. Acrylic Resin B. Mounting System 2. Required Submittals:	A. Product Data 2. Non-Sag Sealants: Permits application in joints on vertical surfaces without sagging or slumping.	requirements, comply with the U.S. Architectural & Transportation Barriers Compliance Board's "Americans with Disabilities Act (ADA), Accessibility Guidelines for Buildings and Facilities (ADAAG)" and ANSI A117.1	1 SET GASKETING 188S BLK ZER 1 EA SURFACE CLOSER 4040XP 689 LCN
 012900 PAYMENT PROCEDURES 1. Schedule of Values Coordination: Coordinate preparation of the schedule of values with preparation of Contractor's construction 	2. Required Submittals: A. Product Data B. Shop Drawings	 General - Sealants and Primers: Provide products having lower volatile organic compound (VOC) content than indicated in SCAQMD 1168. Type - Acoustical Sealant - Acrylic-Urethane Sealant: Water-based; ASTM C920, Grade NS, Uses M and A; single component; paintable; not expected to withotead equipieue water immersion or troffic. 	3. Hinges, general: A. Butts and Hinges: BHMA A156.1.	1 EA CARD READER BY OTHER
schedule. A. Submit to Architect at earliest possible dates, but no later than 7 days before the date scheduled for submittal of initial Application for Payment	B. Shop Drawings 3. Required Submittals: A. Product Data	expected to withstand continuous water immersion or traffic. 1. Movement Capability: Plus and minus 12-1/2 percent, minimum. 2. Hardness Parge: 15 to 40. Share A, when tested in accordance with ASTM C661.	B. Hinge Weight: Heavy-weight hinges. C. Hinge Base Metal: Unless otherwise indicated, provide the following	HARDWARE SET: 04, PROVIDE EA PR OF DOORS WITH THE FOLLOWING: <u>QTY</u> <u>DESCRIPTION</u> <u>CATALOG NUMBER</u> <u>FINISH</u> <u>MFR</u> 4 FA FILE LINIOF
Payment. B. Each Application for Payment following the initial Application for Payment shall be consistent with previous applications and payments as certified by Architect and paid for by Owner.	A. Product Data B. Shop Drawings 4. Acrylic Resin	 Hardness Range: 15 to 40, Shore A, when tested in accordance with ASTM C661. Color: White. Applications: In all wall assemblies. and where not indicated as fire-rated: 	a. Interior Hinges: Steel, with steel pin D. Hinge pins: Use nonrising pins E. Electrified Functions for Hinges: Comply with the following:	1 EA ELEC. HINGE 5BB1 TW8 652 IVE 1 EA ELEC. LOCKSET L9092LEU 06N 626 SCH 5 EA HINCE 5BD14W 652 IVE
 C. Payment Application Times: The date for each progress payment is indicated in the Agreement between Owner and Contractor. The period of construction work covered by each Application for Payment is the period indicated in the Agreement. 	A. Manufacturer - Basis of Design: As indicated in the Drawings B. Thickness: As indicated in the Drawings	 Applications in all wall assembles, and where not indicated as fire-rated. Interior wall and ceiling control joints in non-wet areas. Joints between door, window, and other frames and adjacent construction. 	 E. Electrified Functions for Finges: Comply with the following: 1. Power Transfer: Concealed PTFE-jacketed wires, secured at each leaf and continuous through hinge knuckle. 2. Monitoring: Concealed electrical monitoring switch. 	5 EA HINGE 5BB1HW 652 IVE 1 EA MORTISE CYLINDER AS REQ'D/VERIFY KEYWAY 626 EA WIRE HARNESS CON X LENGTH REQ'D
D. Application of Payment Forms: Use AIA Document G702 and AIA Document G703. E. Application Preparation: Complete every entry on form. Notarize and execute by a person authorized to sign legal documents on	C. Edges: Flame Polished at exposed locations D. Size: As indicated in the Drawings	 Joints between door, window, and other frames and adjacent construction. Gaps between top stud runner and structure, between bottom stud track and floor, between gypsum wall board and floor, and between gypsum wall board and structure. 	 Monitoring: Concealed electrical monitoring switch. Power Transfer and Monitoring: Concealed PTFE-jacketed wires, secured at each leaf and continuous through hinge knuckle, and with concealed electrical monitoring switch. 	EA WIRE HARNESS CON X LENGTH REQ'D 1 EA WALL STOP WS406/407CCV 626 IVE 1 EA GASKETING 4885BK PSA BLK ZER
 E. Application reparation: complete every entry on form rotatize and execute by a person authorized to sign legal documents on behalf of Contractor. Architect will return incomplete applications without action. F. Transmittal: Submit one copy via email to Architect. Email copy shall include waivers of lien and similar attachments if required. 	E. Color: As indicated in the Drawings F. UV Protection: Required	 Gaps at electrical outlets, wiring devices, piping, and other openings; between wall/ceiling and other construction; and other flanking sound paths. 	F. Fasteners: Comply with the following: 1. Machine Screws: For metal doors and frames. Install into drilled and tapped holes.	2 EA DOOR CONTACT 7766 - SCH 1 EA ASTRAGAL 8042S-BK BLK ZER
G. Application for Payment at Substantial Completion: After Architect issues the Certificate of Substantial Completion, submit an Application for Payment showing 100 percent completion for portion of the Work claimed as substantially complete.	G. Expansion/Contraction Allowance: per Manufacturer's Recommendation H. Finish: Standard Vellum	 Type - Mildew-Resistant Joint Sealants - Silicone, Mildew Resistant, Acid Curing, S, NS, 25, NT. Mildew-resistant, single-component, nonsag, plus 25 percent and minus 25 percent movement capability, nontraffic-use, acid-curing silicone joint sealant; ASTM C920, Type S, Grade NS, Class 25, 	 Wood Screws: For wood doors and frames. Threaded-to-the-Head Wood Screws: For fire-rated wood doors. 	2 EA SURFACE CLOSER 4040XP 689 LCN 1 EA CARD READER BY OTHER
 H. Final Payment Application: After completing Project closeout requirements, submit final Application for Payment with releases and supporting documentation not previously submitted and accepted. 		Use NT.	4. Screws: Phillips flat-head; Finish screw heads to match surface of hinges.	
01 02 02	04 05 06	07 00 00		12 14 15

03

04

05

06

07

01

08

09

11

10

12

14



Mid-America Regional Council

MARC PHASE 1 OFFICE RENOVATION

600 BROADWAY BLVD STE 200, KANSAS CITY, MO 64105



MO CERT OF AUTH.: #2016000414 ODIMO PROJ. #: 211002

OWNER

ATTN: CAROL GONZALES, DIRECTOR OF FINANCE AND ADMINISTRATION 600 BROADWAY, SUITE 200 KANSAS CITY, MO 64105 816.701.8204 CGONZALES@MARC.ORG

ARCHITECT

ATTN: AMY J. SLATTERY, AIA ODIMO LLC 701 E 63RD STREET #210 KANSAS CITY, MO 64110 816.708.1500 ASLATTERY@ODIMO.US

MEP ENGINEERING

ATTN: BRAD LEWIS BRANCHPATTERN, INC. 1508 GRAND BOULEVARD KANSAS CITY, MO 64108 816.531.2121 BLEWIS@BRANCHPATTERN.COM

ORIGINAL SHEET ISSUE DATE: 05/31/2022

 \triangle DATE DESCRIPTION

1 06/07/2022 ADDENDUM 01 2 6/14/2022 ADDENDUM 02

ISSUE

BID / PERMIT SET 05/31/2022

SEAL / SIGNATURE



DESCRIPTION

SPECIFICATIONS



©2022 Odimo

15

	01		02	03		. 04	05	06
	HARDWARE	9FT: 05			L	1		
к	PROVIDE EA	SGL OF DOORS WITH TH				098433 SOUND-ABSORBING WA	ALL UNITS	
	<u>QTY</u> 1 EA	DESCRIPTION ELEC. HINGE	CATALOG NUMBER 5BB1 TW8	FINISH MFR 652 IVE		 Required Submittals: A. Product Data 		
	1 EA 1 EA	ELEC. LOCKSET WALL STOP	L9092EUL 06N WS406/407CCV	626 SCH 626 IVE		B. Samples 2. Manufacturer: Basis of Design - A	he indicated on Drawings	
	1 EA	DOOR CONTACT	7766	- SCH		A. Size: Varies, as indicated on D	Drawings.	
	1 EA 1 EA	SURFACE CLOSER MORTISE CYLINDER	4040XP AS REQ'D/VERIFY KEYWAY	689 LCN 7 626		B. Color: Varies, ss indicated on E C. Core: Manufacturer Standard.	Drawings.	
	EA	WIRE HARNESS	CON X LENGTH REQ'D	020		D. Edge: Square		
	1 EA NOTE: BALAI	CARD READER NCE OF HARDWARE IS EX	BY OTHER KISTING AND TO REMAIN. CO	NTACT ARCHITECT IF NOT PRESENT. CONTRA	ACTOR TO	E. Mounting: Adhesive, per Manu	facturer's recommendation.	
	CONFIRM CO	OORDINATION WITH EXIS	TING DOOR WITH FRAME AN	OAGREEMENT WITH EXISTING LEVER SET CU	TOUTS FROM	099123 - INTERIOR PAINTING		
J	CONDITIONS		ARCHITECT IF DOORS REQU	RE ALTERNATE HARDWARE OR FIXTURES DU	E TO EXISTING	1. Required Submittals: A. Product Data		
J	HARDWARE	SET: 06				B. Samples with noted sheen leve 2 Manufacturer: Basis of Design - S	els by location Sherwin Williams - Colors as Indicated on the D)rawinge
	PROVIDE EA	PR OF DOORS WITH THE				3. Material Compatibility:		J. J
	<u>QTY</u> 1 EA	DESCRIPTION ELEC. HINGE	CATALOG NUMBER 5BB1 TW8	FINISH MFR 652 IVE			aint system shall be compatible with one anoth manufacturer, based on testing and field expension of the second s	ner and substrates indicated, under conditions of service and erience.
	1 EA	ELEC. LOCKSET	L9092EUL 06N	626 SCH		B. For each coat in a paint system		y topcoat manufacturers for use in paint system and on
	1 EA 2 EA	GASKETING DOOR CONTACT	488SBK PSA 7766	BLK ZER - SCH		substrate indicated. 4. Int. Painting Schedule:		
	1 EA	ASTRAGAL	8042S-BK	BLK ZER		A. Steel Substrates:	und Later Crateral an VOC	
	1 EA EA	MORTISE CYLINDER WIRE HARNESS	AS REQ'D/VERIFY KEYWAY CON X LENGTH REQ'D	020		 a. High-Performance Architectu b. Prime Coat: Primer, alkyd, q 		
	2 EA 1 EA	SURFACE CLOSER CARD READER	4040XP BY OTHER	689 LCN			terior, high performance architectural, matching n performance architectural, semi-gloss (MPI G	
I	NOTE: COOR	RDINATE W/ EXISTING HO	LD OPENS TO REMAIN. BALA	NCE OF HARDWARE IS EXISTING AND TO REN		B. Galvanized-Metal Substrates:L	Low VOC	
				INATION WITH EXISTING DOOR WITH FRAME . E. NOTIFY THE ARCHITECT IF DOORS REQUIF		 a. High-Performance Architectul b. Prime Coat: Primer, galvaniz 		
		OR FIXTURES DUE TO EX				c. Intermediate Coat: Latex, int	terior, high performance architectural, matching	
	PROVIDE ES	CUTCHEONS / ROSES AS	NEEDED TO COMPLETE HAP	RDWARE SET.		C. Gypsum Board Substrates: Lo	n performance architectural, semi-gloss (MPI G w VOC	IOSS Level 5).
	DIVISION 09					a. High-Performance Architectu b. Prime Coat: Primer sealer, la		
						c. Intermediate Coat: Latex, int	terior, high performance architectural, matching	
		N-STRUCTURAL METAL FF embers, General: Comply w	RAMING ith ASTM C754 for conditions in	licated			n performance architectural, as Indicated in the Architectural woodwork, Doors, and Frames.	Drawings.
	A. Steel Sh	eet Components: Comply w	ith ASTM C645 requirements fo	r steel unless otherwise indicated.		a. High-Performance Architectu	ural Latex System [MPI INT 6.3A]:	
н			53M, G40, hot-dip galvanized un ther conventional steel studs an	ess otherwise indicated. d tracks or embossed, high-strength steel studs ani	d tracks.	 b. Prime Coat: Primer, latex, fo c. Intermediate Coat: Latex, int 	or interior wood[, MPI #39]. terior, high performance architectural, matching	g topcoat.
	A. Manufac	cturers: Subject to compliance	ce with requirements, provide pro				n performance architectural, semi-gloss (MPI G	
	a. ClarkE b. Marino	oWARE.				DIVISION 10 - SPECIALTIES		
		Building Supplies. : As indicated on the Drawin	ne			106700 - WALL SHELVING		
	C. Gauge: /	As indicated on the Drawing	S.			1. Required Submittals:		
		As indicated on the Drawings Head Joints: Where necessa				A. Product Data 2. Manufacturer: Basis of Design: 82	2/182 Series by Knane and Voot	
	A. Deflectio	on Track: Steel sheet top tra	ck manufactured to prevent crac	king of finishes applied to interior partition framing		A. Heavy Duty		
	deflection a. ClarkE		kness not less than indicated for	studs and in width to accommodate depth of studs		 B. Slot design: Double Slot C. Bracket and Standards Color: I 	Black	
G	b. Marino					3. Shelf Depth: 12"		
	B. Resilient		n- deep, steel sheet members de	signed to reduce sound transmission.		 Height: 6'-0" Provide plywood shelves 		
		guration: Single leg. ness: 25 gage, unless other	wise indicated			 Finish: Black Laminate Confirm blocking as required for p 	nroner attachment	
	c. Locati	ion: Where indicated on the	Drawings.			• • •		
		innel: 1/2" deep, steel sheet ness: 25 gage, unless other		I conditions and suspended ceiling system.		DIVISION 11 - EQUIPMENT		
		ion: Where indicated on the				113013 - RESIDENTIAL APPLIANC	ES	
	092900 - GYP					1. Required Submittals: Product Dat	a	
	1. Required S A. Product					2. Dishwasher: A. Manufacturer: Basis of Design	- GE Annliances	
F	B. Samples	3				B. Model: GDT225SGLWW		
	 General - P indicated. 	Provide maximum lengths an	id widths available that will minin	nize joints in each area and that correspond with su	pport system	 a. Requests for substitutions w C. Finish: White. 	ill be considered if in compliance with specifica	tions below and with Architect's approval.
		oard, Type X: ASTM C1396/		uluate hu and of the following:		D. Max Width: 24".		
	a. Georg	jia-Pacific Gypsum LLC.	ce with requirements, provide pro			E. Max Height: 34.5". 3. ADA Compliant.		
		nal Gypsum Company. Corporation.				DIVISION 2 - EUDINISHINGS	$\sim \sim \sim$	$\sim \sim $
	B. Thicknes	ss: 5/8 inch.			~	· · · ·		$\gamma \gamma \gamma \gamma \tau$
	•	lges: Tapered. in all general locations unles	ss in moisture adjacent location.		(122413 WINDOW ROLLER SHADE 1. Required Submittals:	:5	
	4. Mold-Resis	stant Gypsum Board: ASTM	C1396/C1396M gypsum board ce with requirements, provide pro	aduate hy and of the following:	\	1. Product Data		
Е	a. Georg	jia-Pacific Gypsum LLC.	e with requirements, provide pro-		7	 Shop Drawings Samples 		۲
		nal Gypsum Company. Corporation.			(Manual Window Roller Shades Basis of Design: As indicated 		4
	B. Core: 5/8	8 inch, Type X.			7	b. Shade Type: Single Roller.	-	
		lges: Tapered. sistance: ASTM D3273, sco	ore of 10 as rated according to A	STM D3274.	7	 c. Drop Position: Roll in directi d. Mounting: Interior of frame. 	ion of glass. Contractor to field verify with existing conditior	15.
			s at wet locations and where mo im, and control joints complying	d-resistant gypsum board is already installed.		 Size (WxH): Size varies. F e. Fabric: As indicated on the I 	Refer to plan for width of corridor storefront and	l exterior glazing.
	6. Suspended	I Ceiling Support: Metal susp	pension system as necessary fo		Ĺ	f. Color: As indicated on the Di	rawings.	
		wire and attachments as nee nuation Blankets: Unfaced		roduced by combining mineral fibers of type descri	bed below with	 g. Openness: As indicated on t 5. Brackets and Mounting Hardwa 		ounting indicated and to accommodate shade fabric roll-up size
	thermosetti	ing resins to comply with AS	TM C 665 for Type I (blankets w	ithout membrane facing); and as follows:	S	and weight.	·	
	B. Manufac	cturers: One of the following	a flame spread rating of 25 or les or approved equal.	5.	کر	a. Material: Steel, 1/8 inch (3 r 6. Roller Tubes:	nin) (nick .	~
D		s Corning.			(a. Material: Extruded aluminun b. Size: As recommended by r	n. manufacturer; selected for suitability for installa	ation conditions span, and weight of shades
	c. Johns	Manville			\mathbf{b}	c. Fabric Attachment: Utilize e	extruded channel in tube to accept vinyl spline v	welded to fabric edge. Shade band to be removable and
		ss of blankets to be the sam ment: Comply with ASTM C4	e as the depth of the metal stud 475/C475M.	s as indicated in the Drawings.	\succ		g roller tube from brackets or inserting spline fr f being removed and reinstalled without affecting	
	9. Steel Drill S	Screws: ASTM C1002 unless	s otherwise indicated.	Lasan hara (a.a. 0.022 k. 0.440 ia k. 16 ia	(7. Hembars: Designed to maintai	in bottom of shade straight and flat.	
			C954 for fastening panels to stee panels to levels indicated below a	I members from 0.033 to 0.112 inch thick. and according to ASTM C840:	7	 a. Provide the weighted hemba b. Style: Fabric wrapped 	11	
			ealed areas, and where indicate e exposed to view unless otherv		7	8. Accessories:	d aluminum faccia, aiza ao raquirad ta conceal	shade mounting, attachable to brackets without exposed
				ise indicaled.		fasteners.	a aluminum rascia, size as required to concear	
	096513 - RES 1. Required S	-				Finish: AluminimProfile: Square. Slimline.		
C	A. Product	Data						
	B. Samples 2. Wall Base:		ign - As Indicated on the Drawin	gs		125250 UPHOLSTERED FURNIT A. Section Includes:	URE	
				case closer than 24 inches to an external corner. F dures and methods to create continuous base arou		a. Fabric-wrapped built-in seating B. Required Submittals:		
	B. Color: As	s indicated on the Drawings	•		ina sunace.	A. Product Data		
		As indicated on the Drawing As indicated on the Drawing				B. Shop Drawings C. Fabric:		
		Ū	-			a. Basis of Design: As Indicated of		
	096519 - RES 1. Required S	SILIENT TILE FLOORING submittals:				 b. Material: As Indicated on the D c. Pattern: As Indicated on the Dr 		
	A. Product	Data				D. Substrate:	-	
В		rer: Basis of Design - As Ind				a. ½" Plywood substate E. Cushion:		
	A. Color: As	s indicated on the Drawings		n with mill finish of profile and width shown, of heig	ht required to	a. Fill: As indicated on the Drawin b. Thickness: As indicated on the		
	protect exp	osed edge of carpet transition		num lengths to minimize running joints.		c. Provide all required attachment	ts, fasteners, and installation components	· · · · · · · · · · · · · · · · · · ·
		Design: Schluter Systems to be ADA compliant						vide products that pass NFPA 701 as determined by testing or r this Project by a testing and inspecting agency acceptable to
	C. Color to	be selected by Architect.	n floor materiale			authorities having jurisdiction.		
		ate height and transition with es: Manufacturer's recomme						
A								

02

03

04

06

05

09

10

12

13

14

15

G. UPHOLSTERY FABRICATION

07

a. Fabricate upholstery in styles and fullnesses as determined by Architect. If less than a full width of fabric is required to produce panel of specified fullness, use equal widths of not less than one-half width of fabric located at ends of panel.

b. Seams: Sew vertical seams with twin-needle sewing machine with selvage trimmed and overlocked. Join widths so that patterns match and vertical seams lay flat and straight without puckering. Horizontal seams are unacceptable.

08

c. Side Hems: Double-turned, 1-1/2-inch- 38-mm- wide hems consisting of three layers of fabric, and blindstitched so that stitches are invisible

on face of banquette. d. Bottom Hems: Double-turned, 4-inch- (102-mm-) wide hems consisting of three layers of fabric, and weighted and blind-stitched so that

weights and stitches are invisible on face of banquette.

H. UPHOLSTERY INSTALLATION

a. Where fabric abut wood construction, hang so that clearance between fabric and wood construction is 1/8 Inch maximum 6.4 mm.

1

07

10

13

14

15



MARC PHASE 1 OFFICE RENOVATION

600 BROADWAY BLVD STE 200, KANSAS CITY, MO 64105



MO CERT OF AUTH.: #2016000414 ODIMO PROJ. #: 211002

OWNER

ATTN: CAROL GONZALES, DIRECTOR OF FINANCE AND ADMINISTRATION 600 BROADWAY, SUITE 200 KANSAS CITY, MO 64105 816.701.8204 CGONZALES@MARC.ORG

ARCHITECT

ATTN: AMY J. SLATTERY, AIA ODIMO LLC 701 E 63RD STREET #210 KANSAS CITY, MO 64110 816.708.1500 ASLATTERY@ODIMO.US

MEP ENGINEERING

ATTN: BRAD LEWIS BRANCHPATTERN, INC. 1508 GRAND BOULEVARD KANSAS CITY, MO 64108 816.531.2121 BLEWIS@BRANCHPATTERN.COM

0	RIGINAL SHEET ISSUE DATE: 05/31/2022
1	

1 06/07/2022 ADDENDUM 01 2 6/14/2022 ADDENDUM 02

ISSUE

BID / PERMIT SET

WILLING. OF MIS

> -0-00 AMY J.

Instattenter

AMY SLATTERY - ARCHITECT - MO # 2007019930

SPECIFICATIONS

NUMBER (:*: A-2007019930 --- ...

05/31/2022

SEAL / SIGNATURE

N.

TAN


DESCRIPTION


©2022 Odimo

-01:


 \triangle DATE DESCRIPTION

G006

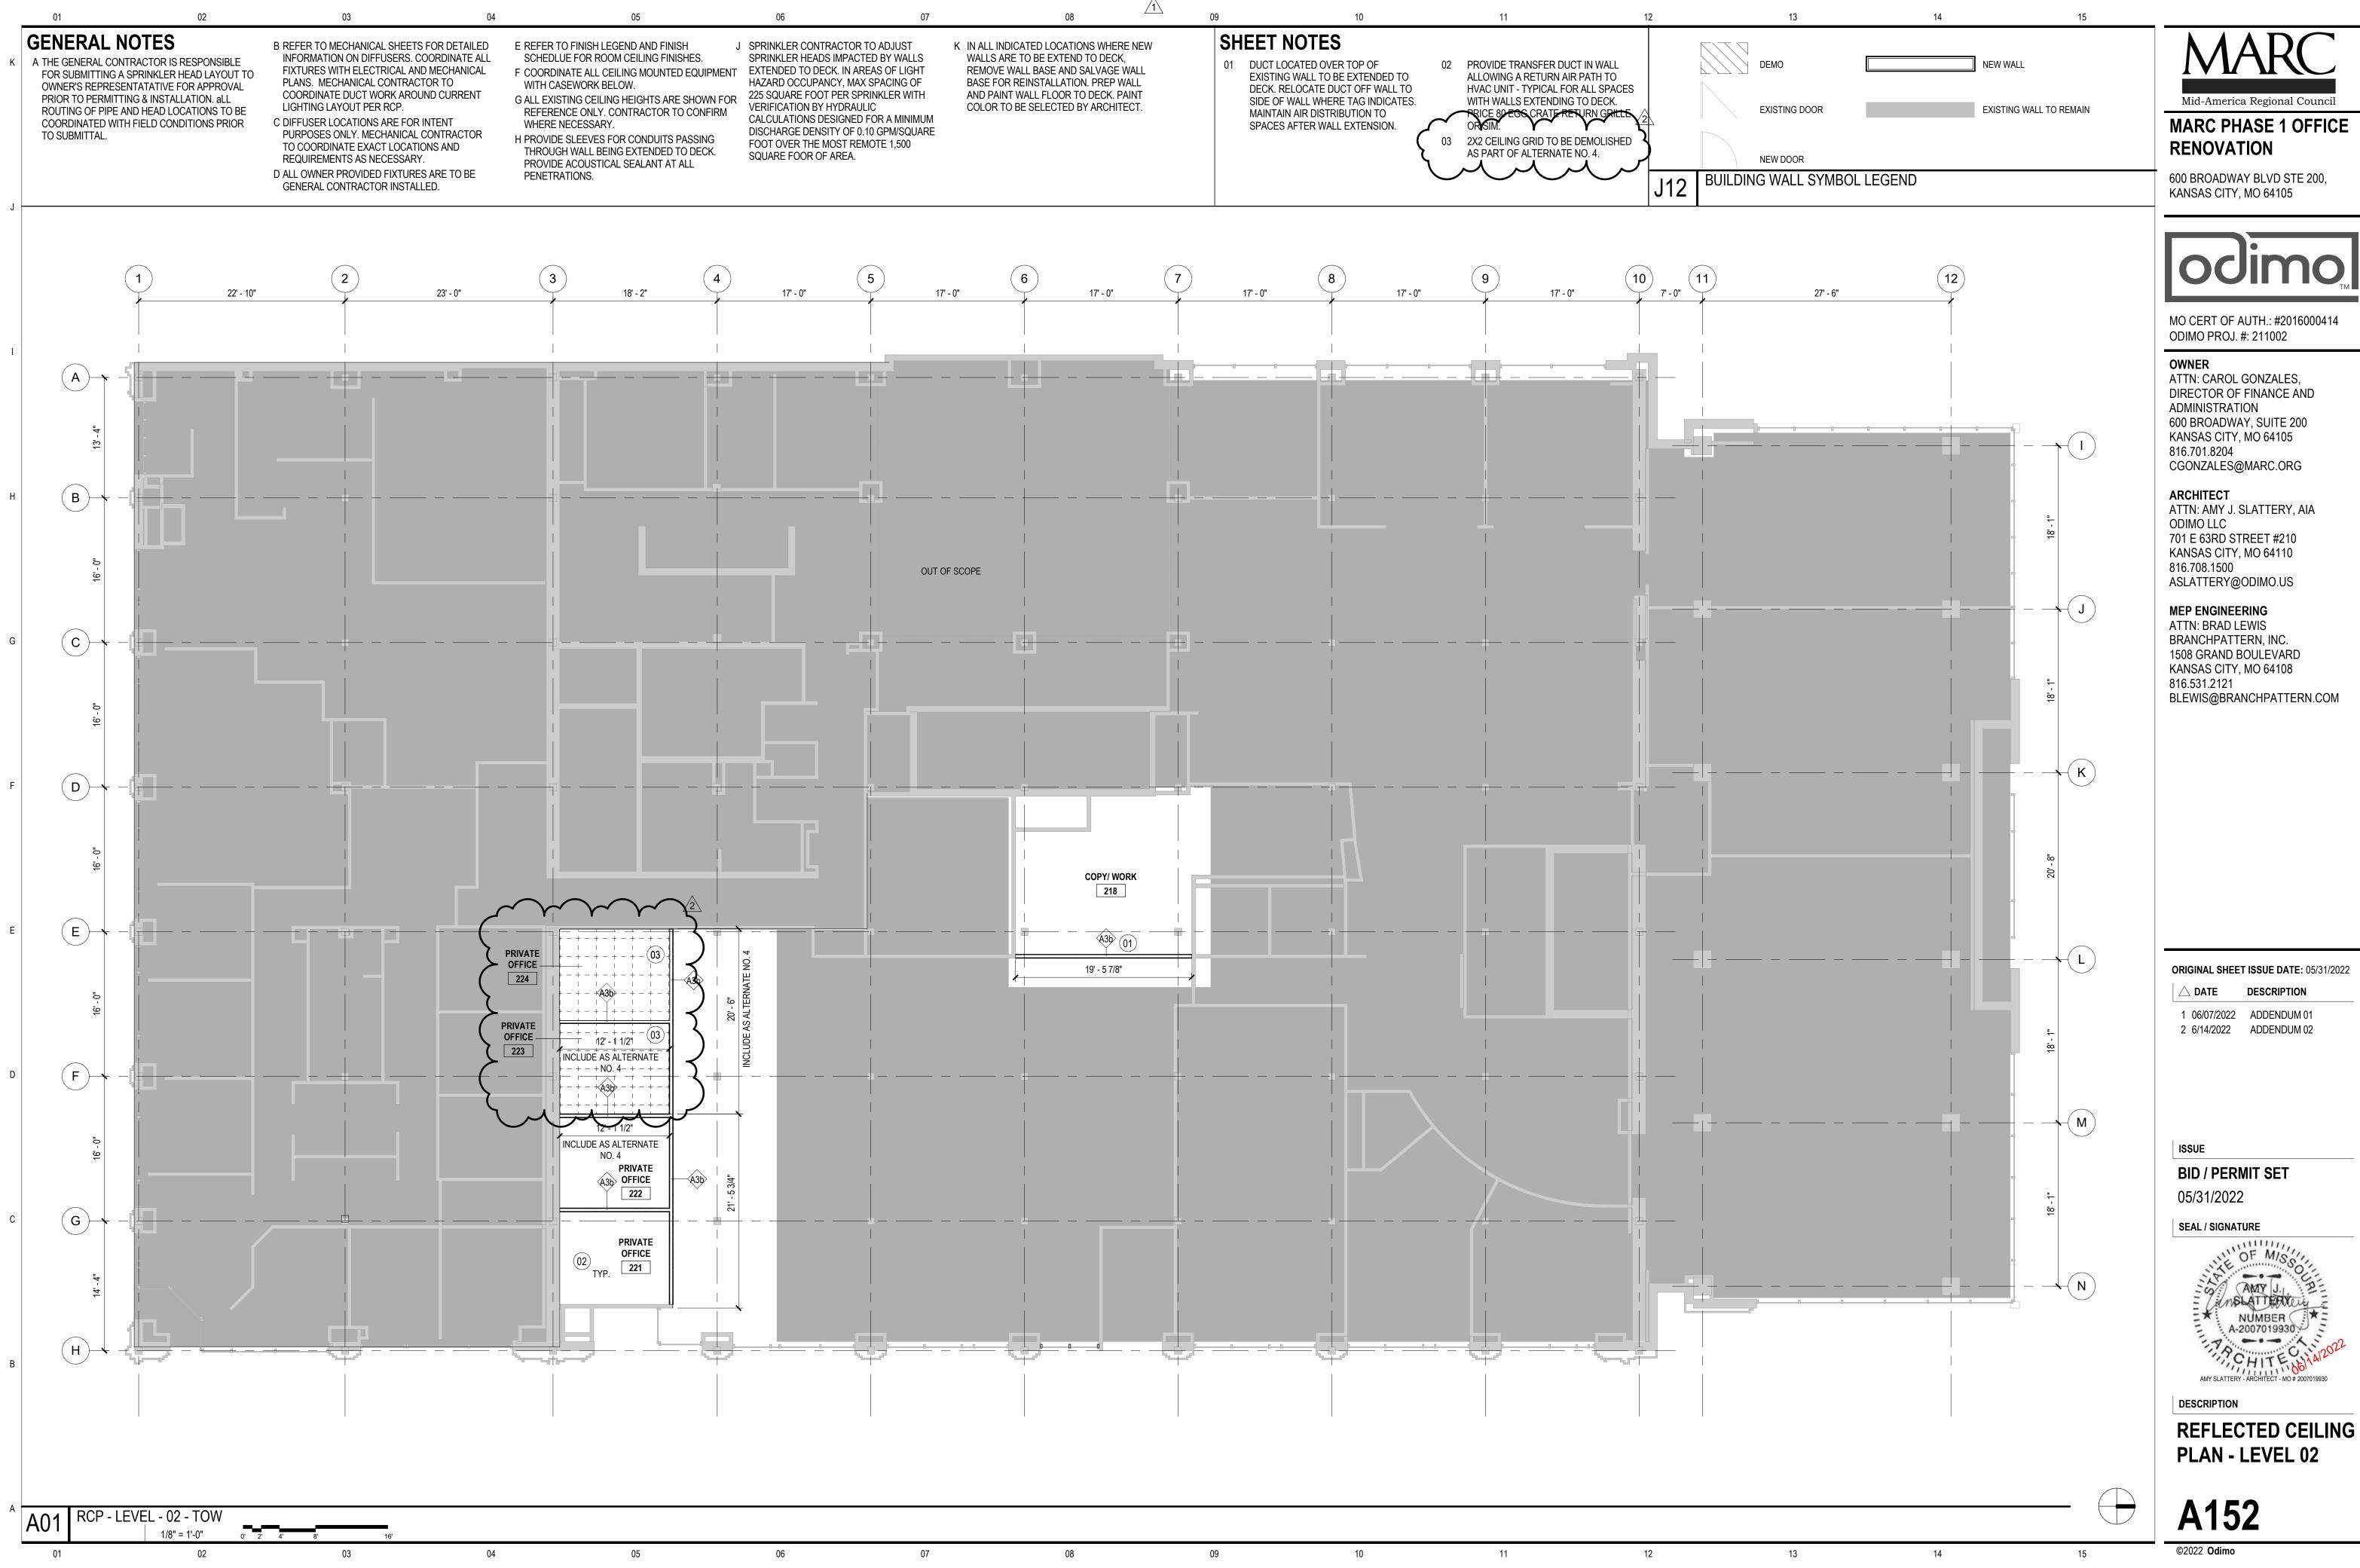

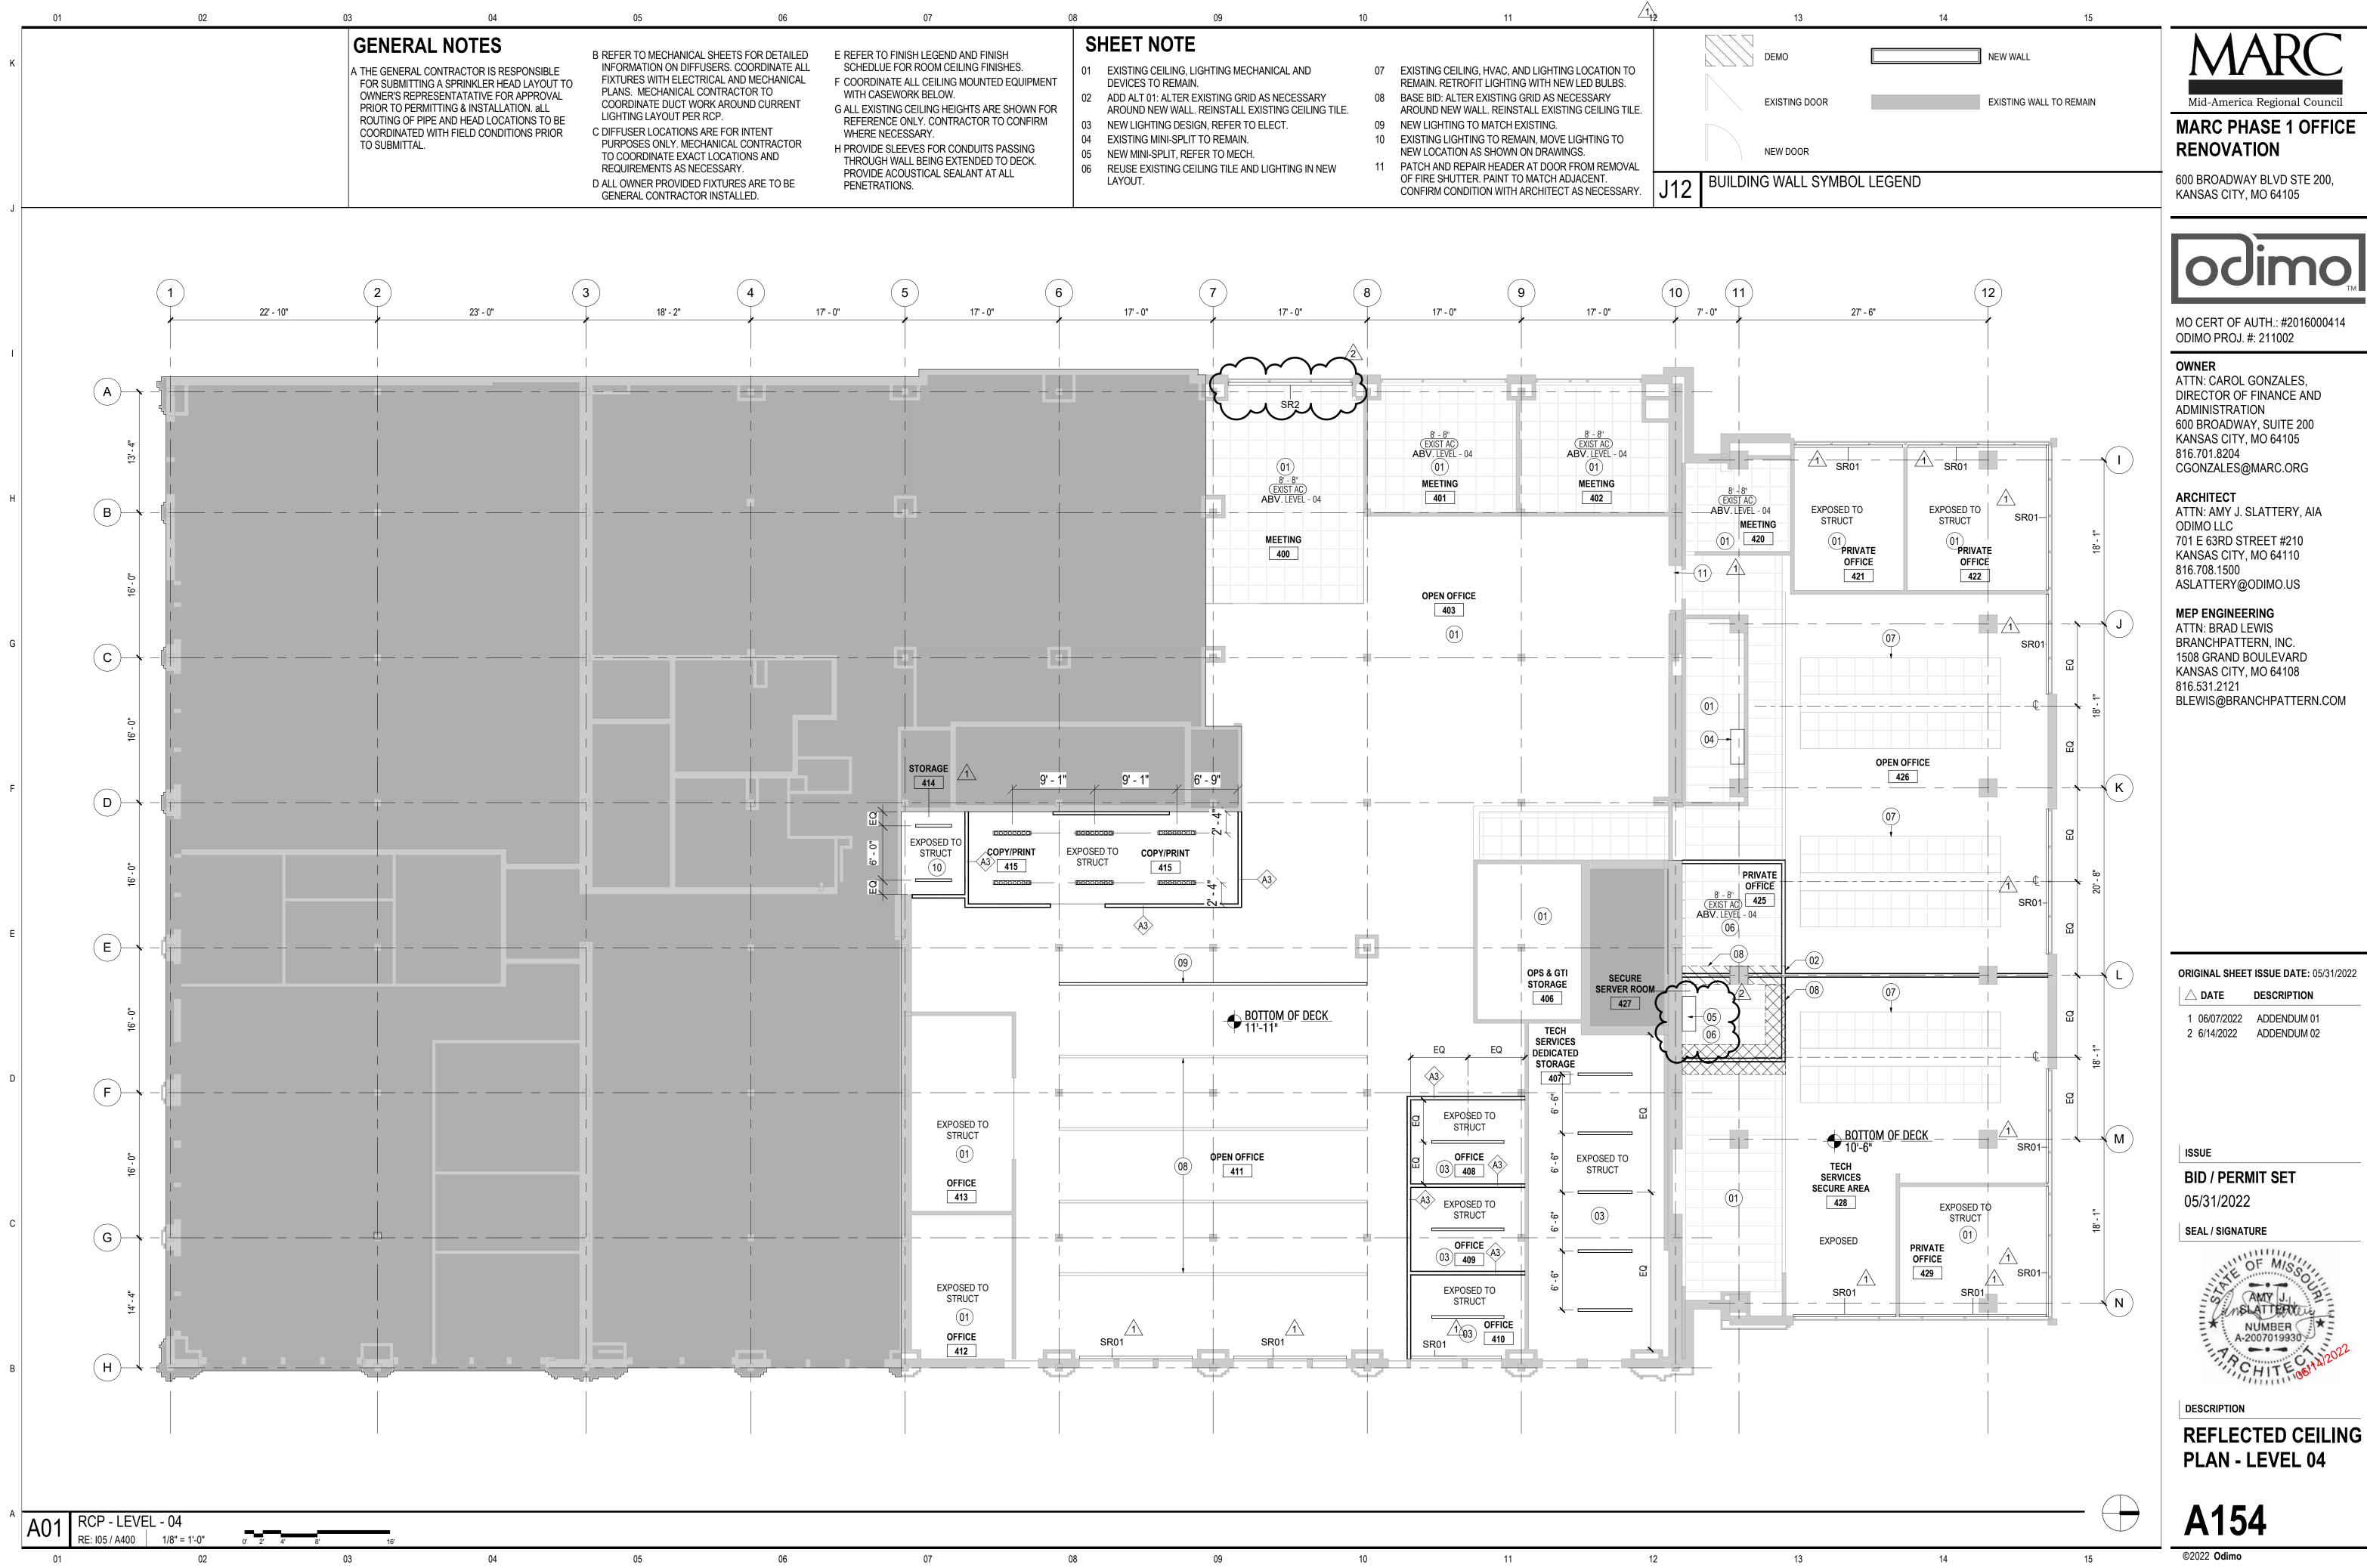


07 08	09 10	10	11 / 1	H2	
07 08 E REFER TO FINISH LEGEND AND FINISH SCHEDLUE FOR ROOM CEILING FINISHES. F COORDINATE ALL CEILING MOUNTED EQUIPMENT WITH CASEWORK BELOW. G ALL EXISTING CEILING HEIGHTS ARE SHOWN FOR REFERENCE ONLY. CONTRACTOR TO CONFIRM WHERE NECESSARY. H PROVIDE SLEEVES FOR CONDUITS PASSING	 SHEET NOTE EXISTING CEILING, LIGHTING MECHANICAL AND DEVICES TO REMAIN. ADD ALT 01: ALTER EXISTING GRID AS NECESSARY AROUND NEW WALL. REINSTALL EXISTING CEILING TILE. NEW LIGHTING DESIGN, REFER TO ELECT. EXISTING MINI-SPLIT TO REMAIN. 	10 07 08 09 10	11 EXISTING CEILING, HVAC, AND LIGHTING LOCATION TO REMAIN. RETROFIT LIGHTING WITH NEW LED BULBS. BASE BID: ALTER EXISTING GRID AS NECESSARY AROUND NEW WALL. REINSTALL EXISTING CEILING TILE. NEW LIGHTING TO MATCH EXISTING. EXISTING LIGHTING TO REMAIN, MOVE LIGHTING TO	2	
H PROVIDE SLEEVES FOR CONDUITS PASSING THROUGH WALL BEING EXTENDED TO DECK. PROVIDE ACOUSTICAL SEALANT AT ALL PENETRATIONS.	 05 NEW MINI-SPLIT, REFER TO MECH. 06 REUSE EXISTING CEILING TILE AND LIGHTING IN NEW LAYOUT. 	11	NEW LOCATION AS SHOWN ON DRAWINGS. PATCH AND REPAIR HEADER AT DOOR FROM REMOVAL OF FIRE SHUTTER. PAINT TO MATCH ADJACENT. CONFIRM CONDITION WITH ARCHITECT AS NECESSARY.	J12	BUI

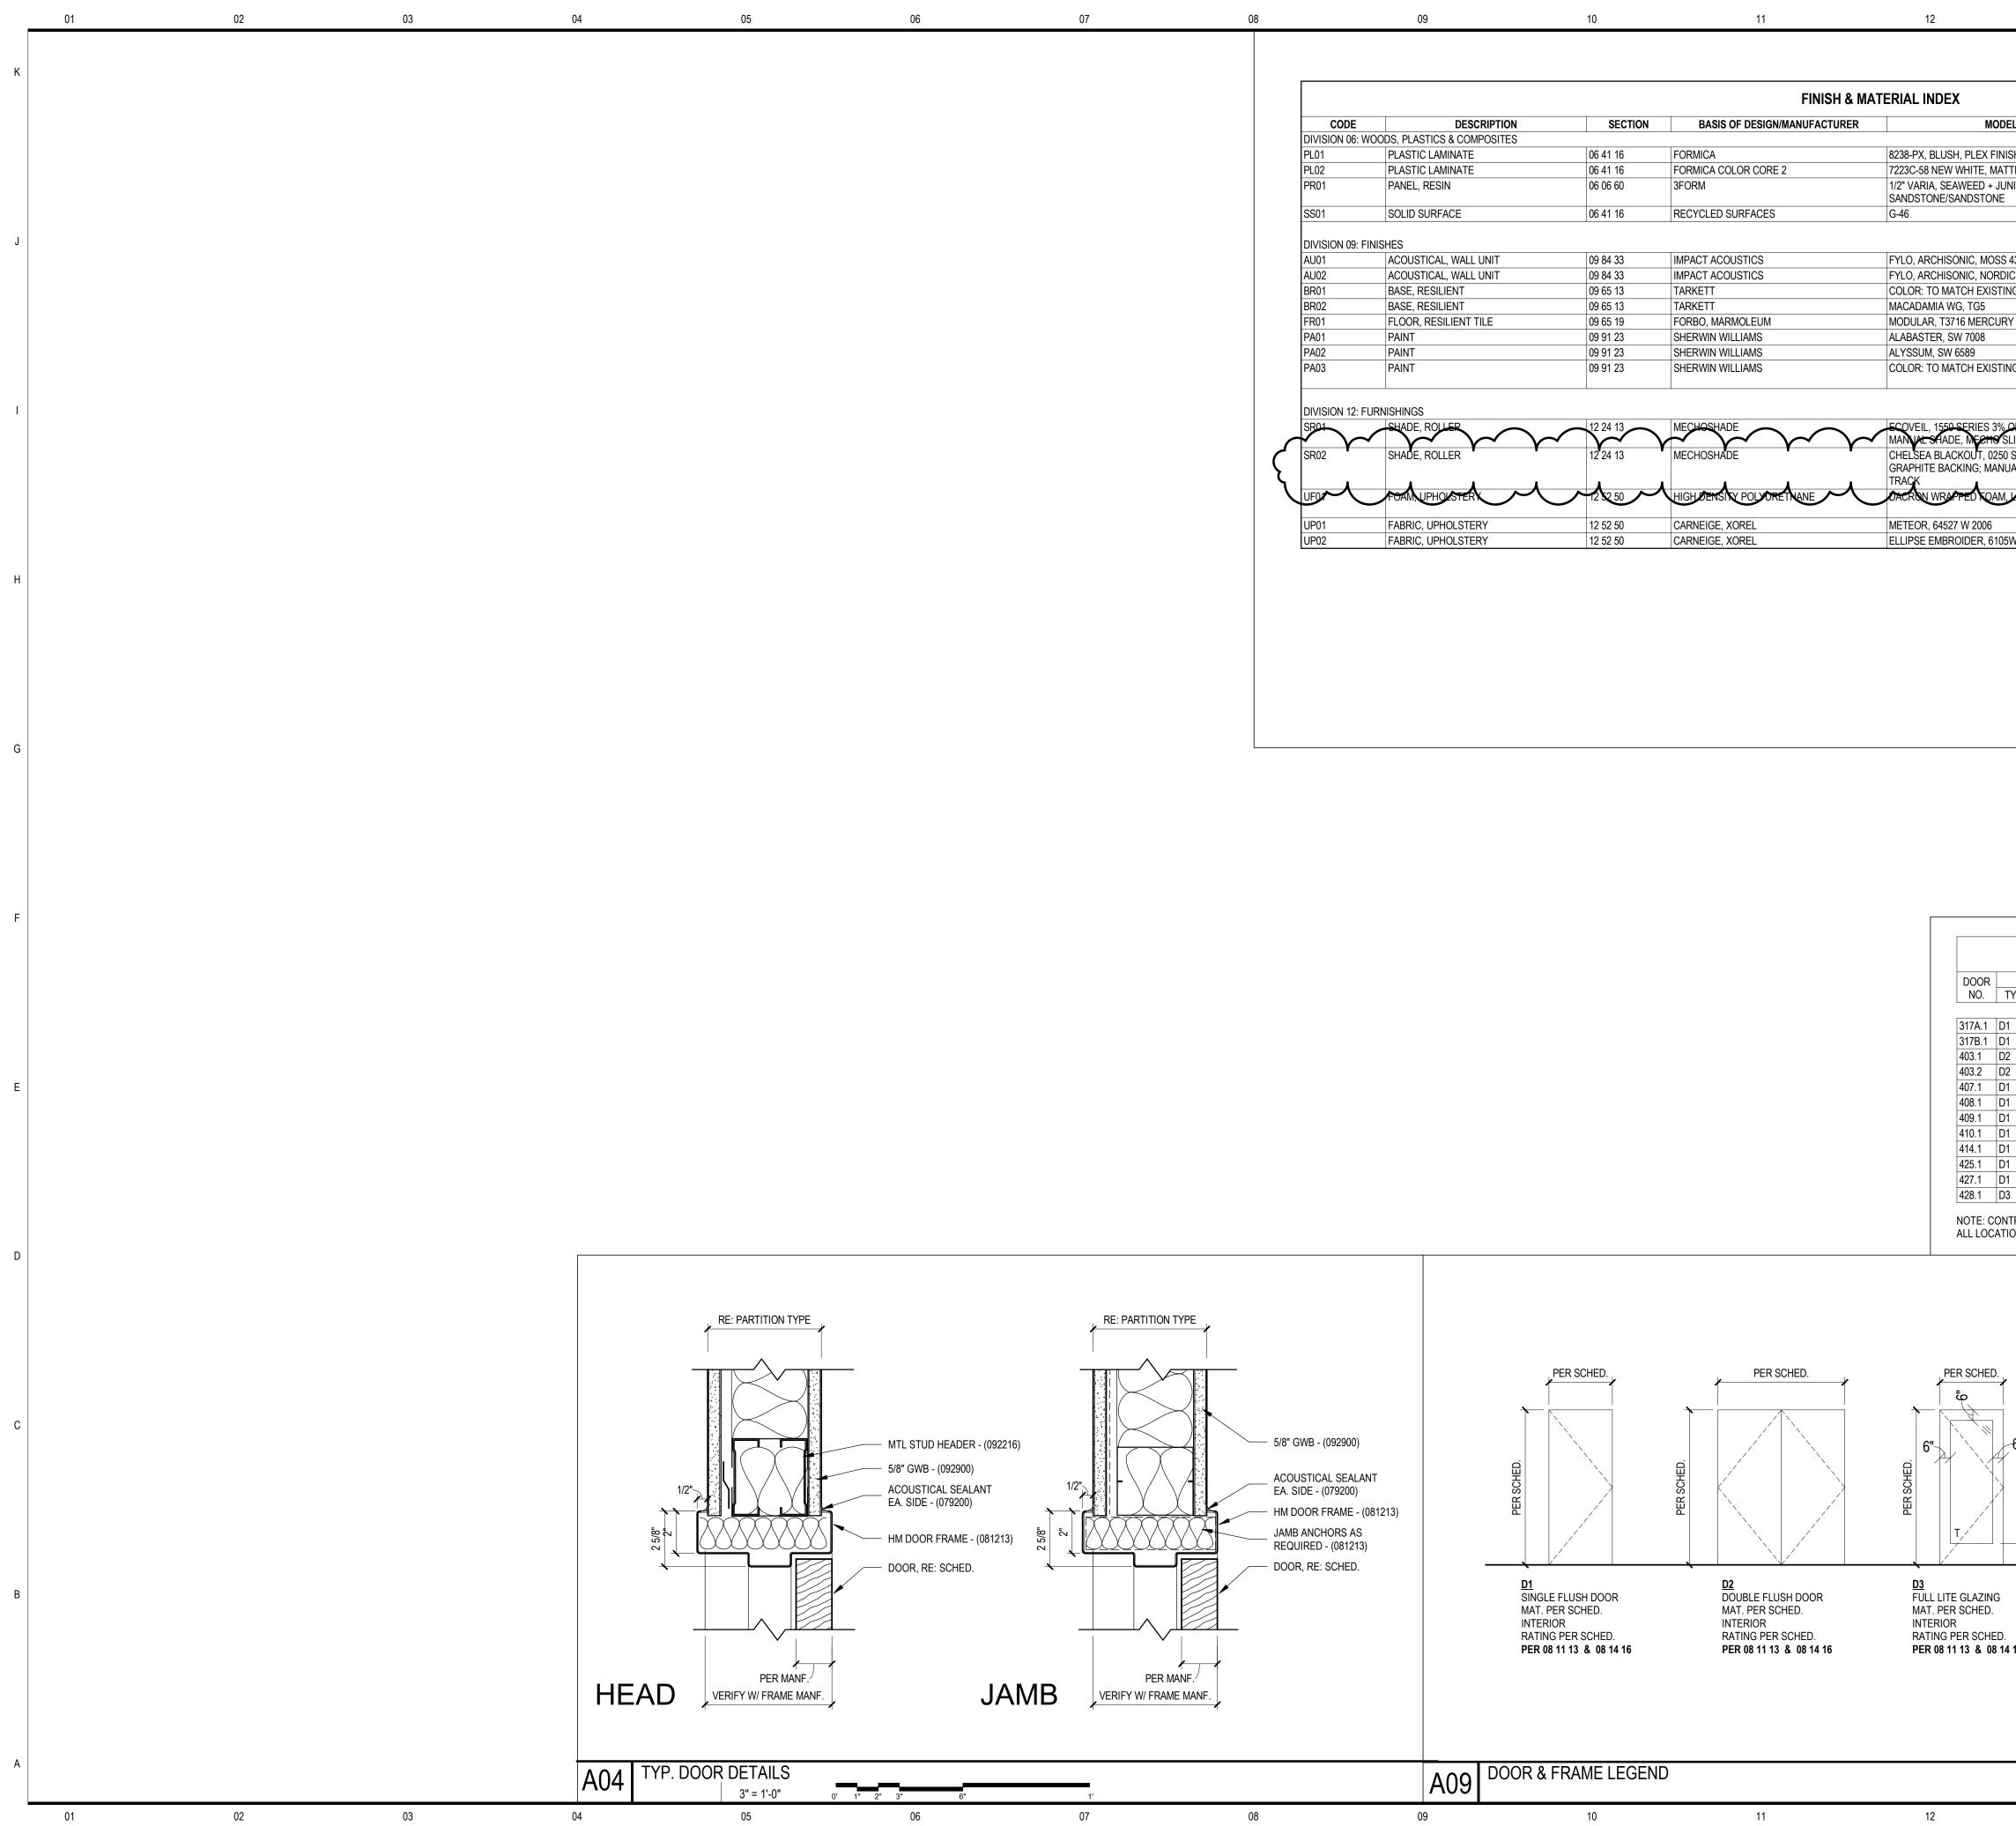



8	09	10	11	12 13	14	15		
							$\underline{1}$	ΝΛΔΟΓ
				TERIAL INDEX				
CODE	DESCRIPTION	SECTION	BASIS OF DESIGN/MANUFACTURER	MODEL/COLOR	SIZE	REMARKS	_	Mid-America Regional Council
	TIC LAMINATE	06 41 16	FORMICA	8238-PX, BLUSH, PLEX FINISH	-	-		MARC PHASE 1 OFFICE
	TIC LAMINATE L, RESIN	06 41 16 06 06 60	FORMICA COLOR CORE 2 3FORM	7223C-58 NEW WHITE, MATTE TEXTURE 1/2" VARIA, SEAWEED + JUNIPER, CENTERED,	- 1/2" THICK	- REFER TO SPEC FOR MOUNTING		RENOVATION
SS01 SOLID) SURFACE	06 41 16	RECYCLED SURFACES	SANDSTONE/SANDSTONE G-46	3/4" THICK	SYSTEM -		600 BROADWAY BLVD STE 200, KANSAS CITY, MO 64105
DIVISION 09: FINISHES								KANSAS CITT, MO 04105
AU02 ACOU	ISTICAL, WALL UNIT ISTICAL, WALL UNIT	09 84 33 09 84 33	IMPACT ACOUSTICS IMPACT ACOUSTICS	FYLO, ARCHISONIC, MOSS 439, 1/2" THICK FYLO, ARCHISONIC, NORDIC PINE 311, 1/2" THICK	SEE ELEVATIONS SEE ELEVATIONS	REFER TO SPEC REFER TO SPEC		
BR02 BASE,	, RESILIENT , RESILIENT	09 65 13 09 65 13	TARKETT TARKETT	COLOR: TO MATCH EXISTING MACADAMIA WG, TG5	4-IN 4-IN	CONTRACTOR TO VERIFY.		odimo
PA01 PAINT		09 65 19 09 91 23	FORBO, MARMOLEUM SHERWIN WILLIAMS	MODULAR, T3716 MERCURY ALABASTER, SW 7008	10" X 20" -	- REFER TO SPEC FOR FINISH.		
PA02 PAINT PA03 PAINT		09 91 23 09 91 23	SHERWIN WILLIAMS SHERWIN WILLIAMS	ALYSSUM, SW 6589 COLOR: TO MATCH EXISTING	-	REFER TO SPEC FOR FINISH REFER TO SPEC FOR FINISH,		MO CERT OF AUTH.: #2016000414
						CONTRACTOR TO VERIFY EXISTING.		ODIMO PROJ. #: 211002
DIVISION 12: FURNISHING SR01 SHAD	E, ROLLER	12 24 13	MECHOSHADE	ECOVEIL, 1550 SERIES 3% OPEN, 1570 SHADOW GREAY; MANUAL SHADE, MECHO SLIMLING TRACK	REFER TO RCPS			
SR02 SHAD	E, ROLLER	12 24 13	MECHOSHADE	CHELSEA BLACKOUT, 0250 SERIES, OPAQUE, 0264 GRAPHITE BACKING; MANUAL SHADE, MECHO SLIMLINE	REFER TO RCPS	γυγυγυ	ר י ע ו	ATTN: CAROL GONZALES, DIRECTOR OF FINANCE AND
		12 \$2 50	HIGH DENSINY POLYORETNANE	TRACK		FLAT SEAMS W SQUARE EDGS, TO		ADMINISTRATION 600 BROADWAY, SUITE 200
UP01 FABRI		12 52 50	CARNEIGE, XOREL	METEOR, 64527 W 2006	SEE DETAILS	STITCHING REFER TO SPEC		KANSAS CITY, MO 64105 816.701.8204
UP02 FABRI	IC, UPHOLSTERY	12 52 50	CARNEIGE, XOREL	ELLIPSE EMBROIDER, 6105W 21	SEE DETAILS	REFER TO SPEC		CGONZALES@MARC.ORG
								ARCHITECT
								ATTN: AMY J. SLATTERY, AIA ODIMO LLC
								701 E 63RD STREET #210 KANSAS CITY, MO 64110
								816.708.1500 ASLATTERY@ODIMO.US
								MEP ENGINEERING ATTN: BRAD LEWIS
								BRANCHPATTERN, INC. 1508 GRAND BOULEVARD
								KANSAS CITY, MO 64108
								816.531.2121 BLEWIS@BRANCHPATTERN.COM
					DOOR SCHEDULE			
				DOORDOORNO.TYPEWIDTHHEIGHTMAT	FRAME ERIAL TYPE MATERIAL	. FIRE RATING HDWR PHA	SING	
				317A.1 D1 3'-0" 7'-0" WD	F2 HM	01 New Cons		
				317B.1 D1 3' - 0" 7' - 0" WD 403.1 D2 1 6' - 0" 6' - 8" HM	F1 HM	1 01 New Cons 3 HR 04 New Cons		
				403.2 D2 5' - 8" 6' - 8" EXIST 407.1 D1 3' - 0" 7' - 0" EXIST	T. EXIST. EXIST.	06 Existing 05 Existing		
				408.1 D1 3' - 0" 7' - 0" WD 409.1 D1 3' - 0" 7' - 0" WD	F2 HM F2 HM	01 New Cons 01 New Cons		
				410.1 D1 3' - 0" 7' - 0" WD 414.1 D1 3' - 0" 7' - 0" WD	F2 HM F1 HM	01 New Cons 02 New Cons		ORIGINAL SHEET ISSUE DATE: 05/31/2022
				425.1 D1 3' - 0" 7' - 0" WD 427.1 D1 3' - 0" 7' - 0" WD	F2 HM F1 HM	01 01 New Cons 02 New Cons		A DATE DESCRIPTION 1 06/07/2022 ADDENDUM 01
				428.1 D3 3' - 0" 7' - 0" WD	F1 HM	03 New Cons		2 6/14/2022 ADDENDUM 01
				NOTE: CONTRACTOR TO COORDINATE NE ALL LOCATIONS.	EW HARDWARE WITH EXISTIN	IG DOORS WHERE NECESSARY. FIELD	VERIFY /1	
								ISSUE
	PER SC	CHED.	PER SCHED.		ER SCHED. 2"	2" PER SCHED. 2" 3' - 0"	-2"	BID / PERMIT SET
]			05/31/2022
— 5/8" GWB - (092900)				6"6"				SEAL / SIGNATURE
ACOUSTICAL SEALANT	SCHED.		HED.			HED		OF MISSIN
EA. SIDE - (079200)	L L L L L L L L L L L L L L L L L L L		PER SCHED.	D D D D D D D D D D D D D D D D D D D		PER SCHED		in the second second
 HM DOOR FRAME - (081213) JAMB ANCHORS AS 		/						Constatteducing =
REQUIRED - (081213) — DOOR, RE: SCHED.						T		A-2007019930
	<u>D1</u> SINGLE FLUSI	1 DOOR	<u>D2</u> DOUBLE FLUSH DOOR	D3 F1 FULL LITE GLAZING HOLLOW M	//ETAL	F2 HOLLOW METAL W/ INTEGRAL SID	DELITE	CHITE CONTAI2022
	MAT. PER SCH INTERIOR	IED.	MAT. PER SCHED. INTERIOR	MAT. PER SCHED. INTERIOR INTERIOR RATING PE	ER DOOR	INTERIOR RATING PER DOOR		111111100
	RATING PER S PER 08 11 13		RATING PER SCHED. PER 08 11 13 & 08 14 16		MATCH ADJ. WALL, UNO	GLAZING PER SPEC PAINT TO MATCH ADJ. WALL, UNC	D I	DESCRIPTION
						PER 08 11 13		DOOR & FINISH
								SCHEDULES
)					A600
	A09		-					
8	09	10	11	12 13	14	15		©2022 Odimo

		13			14	Ļ		15		
DEX										
M	ODEL/COLOR			SI	ZE	F	REMARKS			Mid-Americ
	ATTE TEXTURE		-			-				MARC PH RENOVA
SEAWEED + IE/SANDSTON	JUNIPER, CENTEF NE	₹ED,		THICK		REFER TO SPE SYSTEM	C FOR MOUN	TING		600 BROADWA
			3/4"	THICK		-				KANSAS CITY,
	SS 439, 1/2" THICK RDIC PINE 311, 1/2			E ELEVATIO		REFER TO SPE				
MATCH EXIS A WG, TG5			4-IN 4-IN		лч <u>о</u>	CONTRACTOR				
T3716 MERC R, SW 7008	URY			X 20"		- REFER TO SPE	C FOR FINISH	1.		
SW 6589 MATCH EXIS	STING		-			REFER TO SPE	C FOR FINISH	1		MO CERT OF A
						CONTRACTOR	TO VERIFY E	XISTING.		ODIMO PROJ.
550 SERIES 3	3% OPEN, 1570 SH SLIMLINE TRACK		AY:-REF	ER TO RC	PS				2	
BLACKOUT, 02	250 SERIES, OPAC ANUAL SHADE, ME	QUE, 0264		ER TO RCI	PS PS	γ · · · ·	Ý	Y	5	ATTN: CAROL DIRECTOR OF
		\sim		HICKNESS	\checkmark	FLAT SEAMS W		GIS, TOP	مر	ADMINISTRAT
4527 W 2006	105\\// 21			DETAILS		STITCHING REFER TO SPE				KANSAS CITY, 816.701.8204
/BROIDER, 6 ⁻	100VV Z I		SEE	DETAILS		REFER TO SPE	.0			CGONZALES@
										ARCHITECT ATTN: AMY J. S
										ODIMO LLC 701 E 63RD ST
										KANSAS CITY, 816.708.1500
										ASLATTERY@
										MEP ENGINEE ATTN: BRAD L
										BRANCHPATT 1508 GRAND E
										KANSAS CITY, 816.531.2121
										BLEWIS@BRA
										-
				DOOR S	SCHEDULE					
DOOR NO.	L	door Height N	MATERIAL	F TYPE	RAME MATERIA	L FIRE RATING	HDWR	PHASING	;	
	D1 3' - 0"		VD	F2	HM			New Construct		
403.1	D1 3' - 0" D2 1 6' - 0"			F2	HM HM			New Construct		
1 111-1				F1		3 HR				
403.2 407.1	D2 5' - 8" D1 3' - 0"	6' - 8" E 7' - 0" E	XIST. XIST.	EXIST. EXIST.	EXIST. EXIST.		06 05	Existing Existing	ion	
407.1 408.1 409.1	D1 3' - 0" D1 3' - 0" D1 3' - 0"	6' - 8" E 7' - 0" E 7' - 0" W 7' - 0" W	XIST. XIST. VD VD	EXIST. EXIST. F2 F2	EXIST. EXIST. HM HM		06 05 01 01	Existing New Construct New Construct	tion	
407.1 408.1 409.1 410.1 414.1	D1 3' - 0"	6' - 8" E 7' - 0" E 7' - 0" W	XIST. XIST. VD VD VD VD	EXIST. EXIST. F2 F2 F2 F2 F1	EXIST. EXIST. HM HM HM HM		06 05 01 01 01 01 02	Existing New Construct New Construct New Construct New Construct	tion tion tion	ORIGINAL SHEE
407.1 408.1 409.1 410.1 414.1 425.1 427.1	D1 3' - 0"	6' - 8" E 7' - 0" E 7' - 0" W	XIST. XIST. VD VD VD VD VD VD VD	EXIST. EXIST. F2 F2 F2 F1 F2 F1 F2 F1	EXIST. EXIST. HM HM HM HM HM HM HM		06 05 01 01 01 02 01 02 01 02	Existing New Construct New Construct New Construct New Construct New Construct	tion tion tion tion	
407.1408.1409.1410.1414.1425.1427.1428.1	D1 3' - 0" D3 3' - 0"	6' - 8" E 7' - 0" E 7' - 0" W	XIST. XIST. VD VD VD VD VD VD VD VD	EXIST. EXIST. F2 F2 F2 F1 F2 F1 F2 F1 F1 F1	EXIST. EXIST. HM HM HM HM HM HM HM HM		06 05 01 01 02 01 02 03	Existing New Construct New Construct New Construct New Construct New Construct New Construct New Construct	tion tion tion tion tion	
407.1408.1409.1410.1414.1425.1427.1428.1	D1 3' - 0" D3 3' - 0" ONTRACTOR TO 0	6' - 8" E 7' - 0" E 7' - 0" W	XIST. XIST. VD VD VD VD VD VD VD VD	EXIST. EXIST. F2 F2 F2 F1 F2 F1 F2 F1 F1 F1	EXIST. EXIST. HM HM HM HM HM HM HM HM	3 HK	06 05 01 01 02 01 02 03	Existing New Construct New Construct New Construct New Construct New Construct New Construct New Construct	tion tion tion tion tion	△ DATE 1 06/07/2022
407.1 408.1 409.1 410.1 414.1 425.1 427.1 428.1 NOTE: C	D1 3' - 0" D3 3' - 0" ONTRACTOR TO 0	6' - 8" E 7' - 0" E 7' - 0" W	XIST. XIST. VD VD VD VD VD VD VD VD	EXIST. EXIST. F2 F2 F2 F1 F2 F1 F2 F1 F1 F1	EXIST. EXIST. HM HM HM HM HM HM HM HM		06 05 01 01 02 01 02 03	Existing New Construct New Construct New Construct New Construct New Construct New Construct New Construct	tion tion tion tion tion	△ DATE 1 06/07/2022
407.1 408.1 409.1 410.1 414.1 425.1 427.1 428.1 NOTE: C	D1 3' - 0" D1 3' - 0" D3 3' - 0" ONTRACTOR TO 0 ATIONS.	6' - 8" E 7' - 0" E 7' - 0" W 7' - 0" W COORDINAT	XIST. XIST. VD VD VD VD VD VD E NEW HA	EXIST. EXIST. F2 F2 F1 F2 F1 F1 F1 ARDWARE	EXIST. EXIST. HM HM HM HM HM HM HM HM	2"PER SCI	06 05 01 01 02 01 1 02 03 E NECESSAR	Existing New Construct New Construct New Construct New Construct New Construct New Construct New Construct	tion tion tion tion tion	△ DATE 1 06/07/2022 2 6/14/2022
407.1 408.1 409.1 410.1 414.1 425.1 427.1 428.1 NOTE: C ALL LOC	D1 3' - 0" D1 3' - 0" D3 3' - 0" ONTRACTOR TO 0 ATIONS.	6' - 8" E 7' - 0" E 7' - 0" W 7' - 0" W	XIST. XIST. VD VD VD VD VD VD E NEW HA	EXIST. EXIST. F2 F2 F1 F2 F1 F1 F1 ARDWARE	EXIST. EXIST. HM HM HM HM HM HM HM HM	NG DOORS WHER	06 05 01 01 02 01 1 02 03 E NECESSAR	Existing New Construct New Construct New Construct New Construct New Construct New Construct Y. FIELD VEF	tion tion tion tion tion	△ DATE 1 06/07/2022 2 6/14/2022 ISSUE
407.1 408.1 409.1 410.1 414.1 425.1 427.1 428.1 NOTE: C ALL LOC	D1 3' - 0" D1 3' - 0" D3 3' - 0" ONTRACTOR TO 0 ATIONS.	6' - 8" E 7' - 0" E 7' - 0" W 7' - 0" W COORDINAT	XIST. XIST. VD VD VD VD VD VD E NEW HA	EXIST. EXIST. F2 F2 F1 F2 F1 F1 F1 ARDWARE	EXIST. EXIST. HM HM HM HM HM HM HM HM	NG DOORS WHER	06 05 01 01 02 01 1 02 03 E NECESSAR	Existing New Construct New Construct New Construct New Construct New Construct New Construct Y. FIELD VEF	tion tion tion tion tion	△ DATE 1 06/07/2022 2 6/14/2022 ISSUE BID / PERI
407.1 408.1 409.1 410.1 414.1 425.1 427.1 428.1 NOTE: C ALL LOC	D1 3' - 0" D1 3' - 0" D3 3' - 0" ONTRACTOR TO C ATIONS.	6' - 8" E 7' - 0" E 7' - 0" W 7' - 0" W COORDINAT	XIST. XIST. VD VD VD VD VD VD E NEW HA	EXIST. EXIST. F2 F2 F1 F2 F1 F1 F1 ARDWARE	EXIST. EXIST. HM HM HM HM HM HM HM HM	2" PER SCI	06 05 01 01 02 01 1 02 03 E NECESSAR	Existing New Construct New Construct New Construct New Construct New Construct New Construct Y. FIELD VEF	tion tion tion tion tion	 △ DATE 1 06/07/2022 2 6/14/2022 ISSUE BID / PERI 05/31/2022
407.1 408.1 409.1 410.1 414.1 425.1 427.1 428.1 NOTE: C ALL LOC	D1 3' - 0" D1 3' - 0" D3 3' - 0" ONTRACTOR TO C ATIONS.	6' - 8" E 7' - 0" E 7' - 0" W 7' - 0" W COORDINAT	XIST. XIST. VD VD VD VD VD VD E NEW HA	EXIST. EXIST. F2 F2 F1 F2 F1 F1 F1 ARDWARE	EXIST. EXIST. HM HM HM HM HM HM HM HM	NG DOORS WHER	06 05 01 01 02 01 1 02 03 E NECESSAR	Existing New Construct New Construct New Construct New Construct New Construct New Construct Y. FIELD VEF	tion tion tion tion tion	 △ DATE 1 06/07/2022 2 6/14/2022 ISSUE BID / PERI 05/31/2022
407.1 408.1 409.1 410.1 414.1 425.1 427.1 428.1 NOTE: C ALL LOC	D1 3' - 0" D1 3' - 0" D3 3' - 0" ONTRACTOR TO C ATIONS.	6' - 8" E 7' - 0" E 7' - 0" W 7' - 0" W COORDINAT	XIST. XIST. VD VD VD VD VD VD E NEW HA	EXIST. EXIST. F2 F2 F1 F2 F1 F1 F1 ARDWARE	EXIST. EXIST. HM HM HM HM HM HM HM HM	2" PER SCI	06 05 01 01 02 01 1 02 03 E NECESSAR	Existing New Construct New Construct New Construct New Construct New Construct New Construct Y. FIELD VEF	tion tion tion tion tion	△ DATE 1 06/07/2022 2 6/14/2022 ISSUE BID / PERI 05/31/2022 SEAL / SIGNAT
407.1 408.1 409.1 410.1 414.1 425.1 427.1 428.1 NOTE: C ALL LOC	D1 3' - 0" D1 3' - 0" D3 3' - 0" ONTRACTOR TO C ATIONS.	6' - 8" E 7' - 0" E 7' - 0" W 7' - 0" W COORDINAT	XIST. XIST. VD VD VD VD VD VD E NEW HA	EXIST. EXIST. F2 F2 F1 F2 F1 F1 F1 ARDWARE	EXIST. EXIST. HM HM HM HM HM HM HM HM	2" PER SCI	06 05 01 01 02 01 1 02 03 E NECESSAR	Existing New Construct New Construct New Construct New Construct New Construct New Construct Y. FIELD VEF	tion tion tion tion tion	△ DATE 1 06/07/2022 2 6/14/2022 ISSUE BID / PERI 05/31/2022 SEAL / SIGNAT
407.1 408.1 409.1 410.1 414.1 425.1 427.1 428.1 NOTE: C ALL LOC	D1 3' - 0" D1 3' - 0" D3 3' - 0" ONTRACTOR TO C ATIONS.	6' - 8" E 7' - 0" E 7' - 0" W 7' - 0" W	XIST. XIST. VD VD VD VD VD VD E NEW HA PER SCH	EXIST. EXIST. F2 F2 F1 F2 F1 F1 RDWARE	EXIST. EXIST. HM HM HM HM HM HM HM HM	2" PER SCI QHOS WHER F2 HOLLOW ME	06 05 01 01 02 01 1 02 03 E NECESSAR	Existing New Construct New Con	tion tion tion tion tion RIFY	△ DATE 1 06/07/2022 2 6/14/2022 ISSUE BID / PERI 05/31/2022 SEAL / SIGNAT
407.1 408.1 409.1 410.1 414.1 425.1 427.1 428.1 NOTE: C ALL LOC	D1 3' - 0" D1 3' - 0" D3 3' - 0" ONTRACTOR TO CATIONS.	6' - 8" E 7' - 0" E 7' - 0" W 7' - 0" W COORDINAT	XIST. XIST. VD VD VD VD VD VD E NEW HA PER SCH PER SCH C S PER DO	EXIST. EXIST. F2 F2 F1 F2 F1 F1 RDWARE 2"	EXIST. EXIST. HM HM HM HM HM WITH EXISTI	2" PER SCI QHOS WHER F2	06 05 01 01 02 01 1 02 03 E NECESSAR HED. 2" T	Existing New Construct New Con	tion tion tion tion tion RIFY	△ DATE 1 06/07/2022 2 6/14/2022 ISSUE BID / PERI 05/31/2022 SEAL / SIGNAT
407.1 408.1 409.1 410.1 414.1 425.1 427.1 428.1 NOTE: CLAZING PER SCHED T	D1 3' - 0" D1 3' - 0" D3 3' - 0" ONTRACTOR TO (ATIONS.	6' - 8" E 7' - 0" E 7' - 0" W 7' - 0" W COORDINAT	XIST. XIST. VD VD VD VD VD VD E NEW HA PER SCH PER SCH OR 3 PER DO TO MATCI	EXIST. EXIST. F2 F2 F1 F2 F1 F1 RDWARE V ARDWARE V OR	EXIST. EXIST. HM HM HM HM HM WITH EXISTI	2" PER SCI QUINCE DOORS WHER	06 05 01 01 02 01 02 03 E NECESSAR HED. 2" T T T T T T T T T T T T T T T T T T T	Existing New Construct New Con	tion tion tion tion tion RIFY	DATE 1 06/07/2022 2 6/14/2022 SEAL / SIGNAT SEAL / SIGNAT DESCRIPTION
407.1 408.1 409.1 410.1 410.1 414.1 425.1 427.1 428.1 NOTE: CL ALL LOC.	D1 3' - 0" D1 3' - 0" D3 3' - 0" ONTRACTOR TO (ATIONS.	6' - 8" E 7' - 0" E 7' - 0" W 7' - 0" W COORDINAT	XIST. XIST. VD VD VD VD VD VD E NEW HA PER SCH PER SCH OR 3 PER DO TO MATCI	EXIST. EXIST. F2 F2 F1 F2 F1 F1 RDWARE V ARDWARE V OR	EXIST. EXIST. HM HM HM HM HM WITH EXISTI	2" PER SCI	06 05 01 01 02 01 02 03 E NECESSAR HED. 2" T T T T T T T T T T T T T T T T T T T	Existing New Construct New Con	tion tion tion tion tion RIFY	DATE 1 06/07/2022 2 6/14/2022 SEAL / SIGNAT DESCRIPTION DESCRIPTION
407.1 408.1 409.1 410.1 410.1 414.1 425.1 427.1 428.1 NOTE: CL ALL LOC.	D1 3' - 0" D1 3' - 0" D3 3' - 0" ONTRACTOR TO (ATIONS.	6' - 8" E 7' - 0" E 7' - 0" W 7' - 0" W COORDINAT	XIST. XIST. VD VD VD VD VD VD E NEW HA PER SCH PER SCH OR 3 PER DO TO MATCI	EXIST. EXIST. F2 F2 F1 F2 F1 F1 RDWARE V ARDWARE V OR	EXIST. EXIST. HM HM HM HM HM WITH EXISTI	2" PER SCI	06 05 01 01 02 01 02 03 E NECESSAR HED. 2" T T T T T T T T T T T T T T T T T T T	Existing New Construct New Con	tion tion tion tion tion RIFY	DATE 1 06/07/2022 2 6/14/2022 SEAL / SIGNAT SEAL / SIGNAT DESCRIPTION
407.1 408.1 409.1 410.1 410.1 414.1 425.1 427.1 428.1 NOTE: CL ALL LOC.	D1 3' - 0" D1 3' - 0" D3 3' - 0" ONTRACTOR TO (ATIONS.	6' - 8" E 7' - 0" E 7' - 0" W 7' - 0" W COORDINAT	XIST. XIST. VD VD VD VD VD VD E NEW HA PER SCH PER SCH OR 3 PER DO TO MATCI	EXIST. EXIST. F2 F2 F1 F2 F1 F1 RDWARE V ARDWARE V OR	EXIST. EXIST. HM HM HM HM HM WITH EXISTI	2" PER SCI	06 05 01 01 02 01 02 03 E NECESSAR HED. 2" T T T T T T T T T T T T T T T T T T T	Existing New Construct New Con	tion tion tion tion tion RIFY	DATE 1 06/07/2022 2 6/14/2022 SEAL / SIGNAT DESCRIPTION DOOR 8 SCHEDU
407.1 408.1 409.1 410.1 410.1 414.1 425.1 427.1 428.1 NOTE: CL ALL LOC.	D1 3' - 0" D1 3' - 0" D3 3' - 0" ONTRACTOR TO (ATIONS.	6' - 8" E 7' - 0" E 7' - 0" W 7' - 0" W COORDINAT	XIST. XIST. VD VD VD VD VD VD E NEW HA PER SCH PER SCH OR 3 PER DO TO MATCI	EXIST. EXIST. F2 F2 F1 F2 F1 F1 RDWARE V ARDWARE V OR	EXIST. EXIST. HM HM HM HM HM WITH EXISTI	2" PER SCI	06 05 01 01 02 01 02 03 E NECESSAR HED. 2" T T T T T T T T T T T T T T T T T T T	Existing New Construct New Con	tion tion tion tion tion RIFY	DATE 1 06/07/2022 2 6/14/2022 SEAL / SIGNAT DESCRIPTION DESCRIPTION



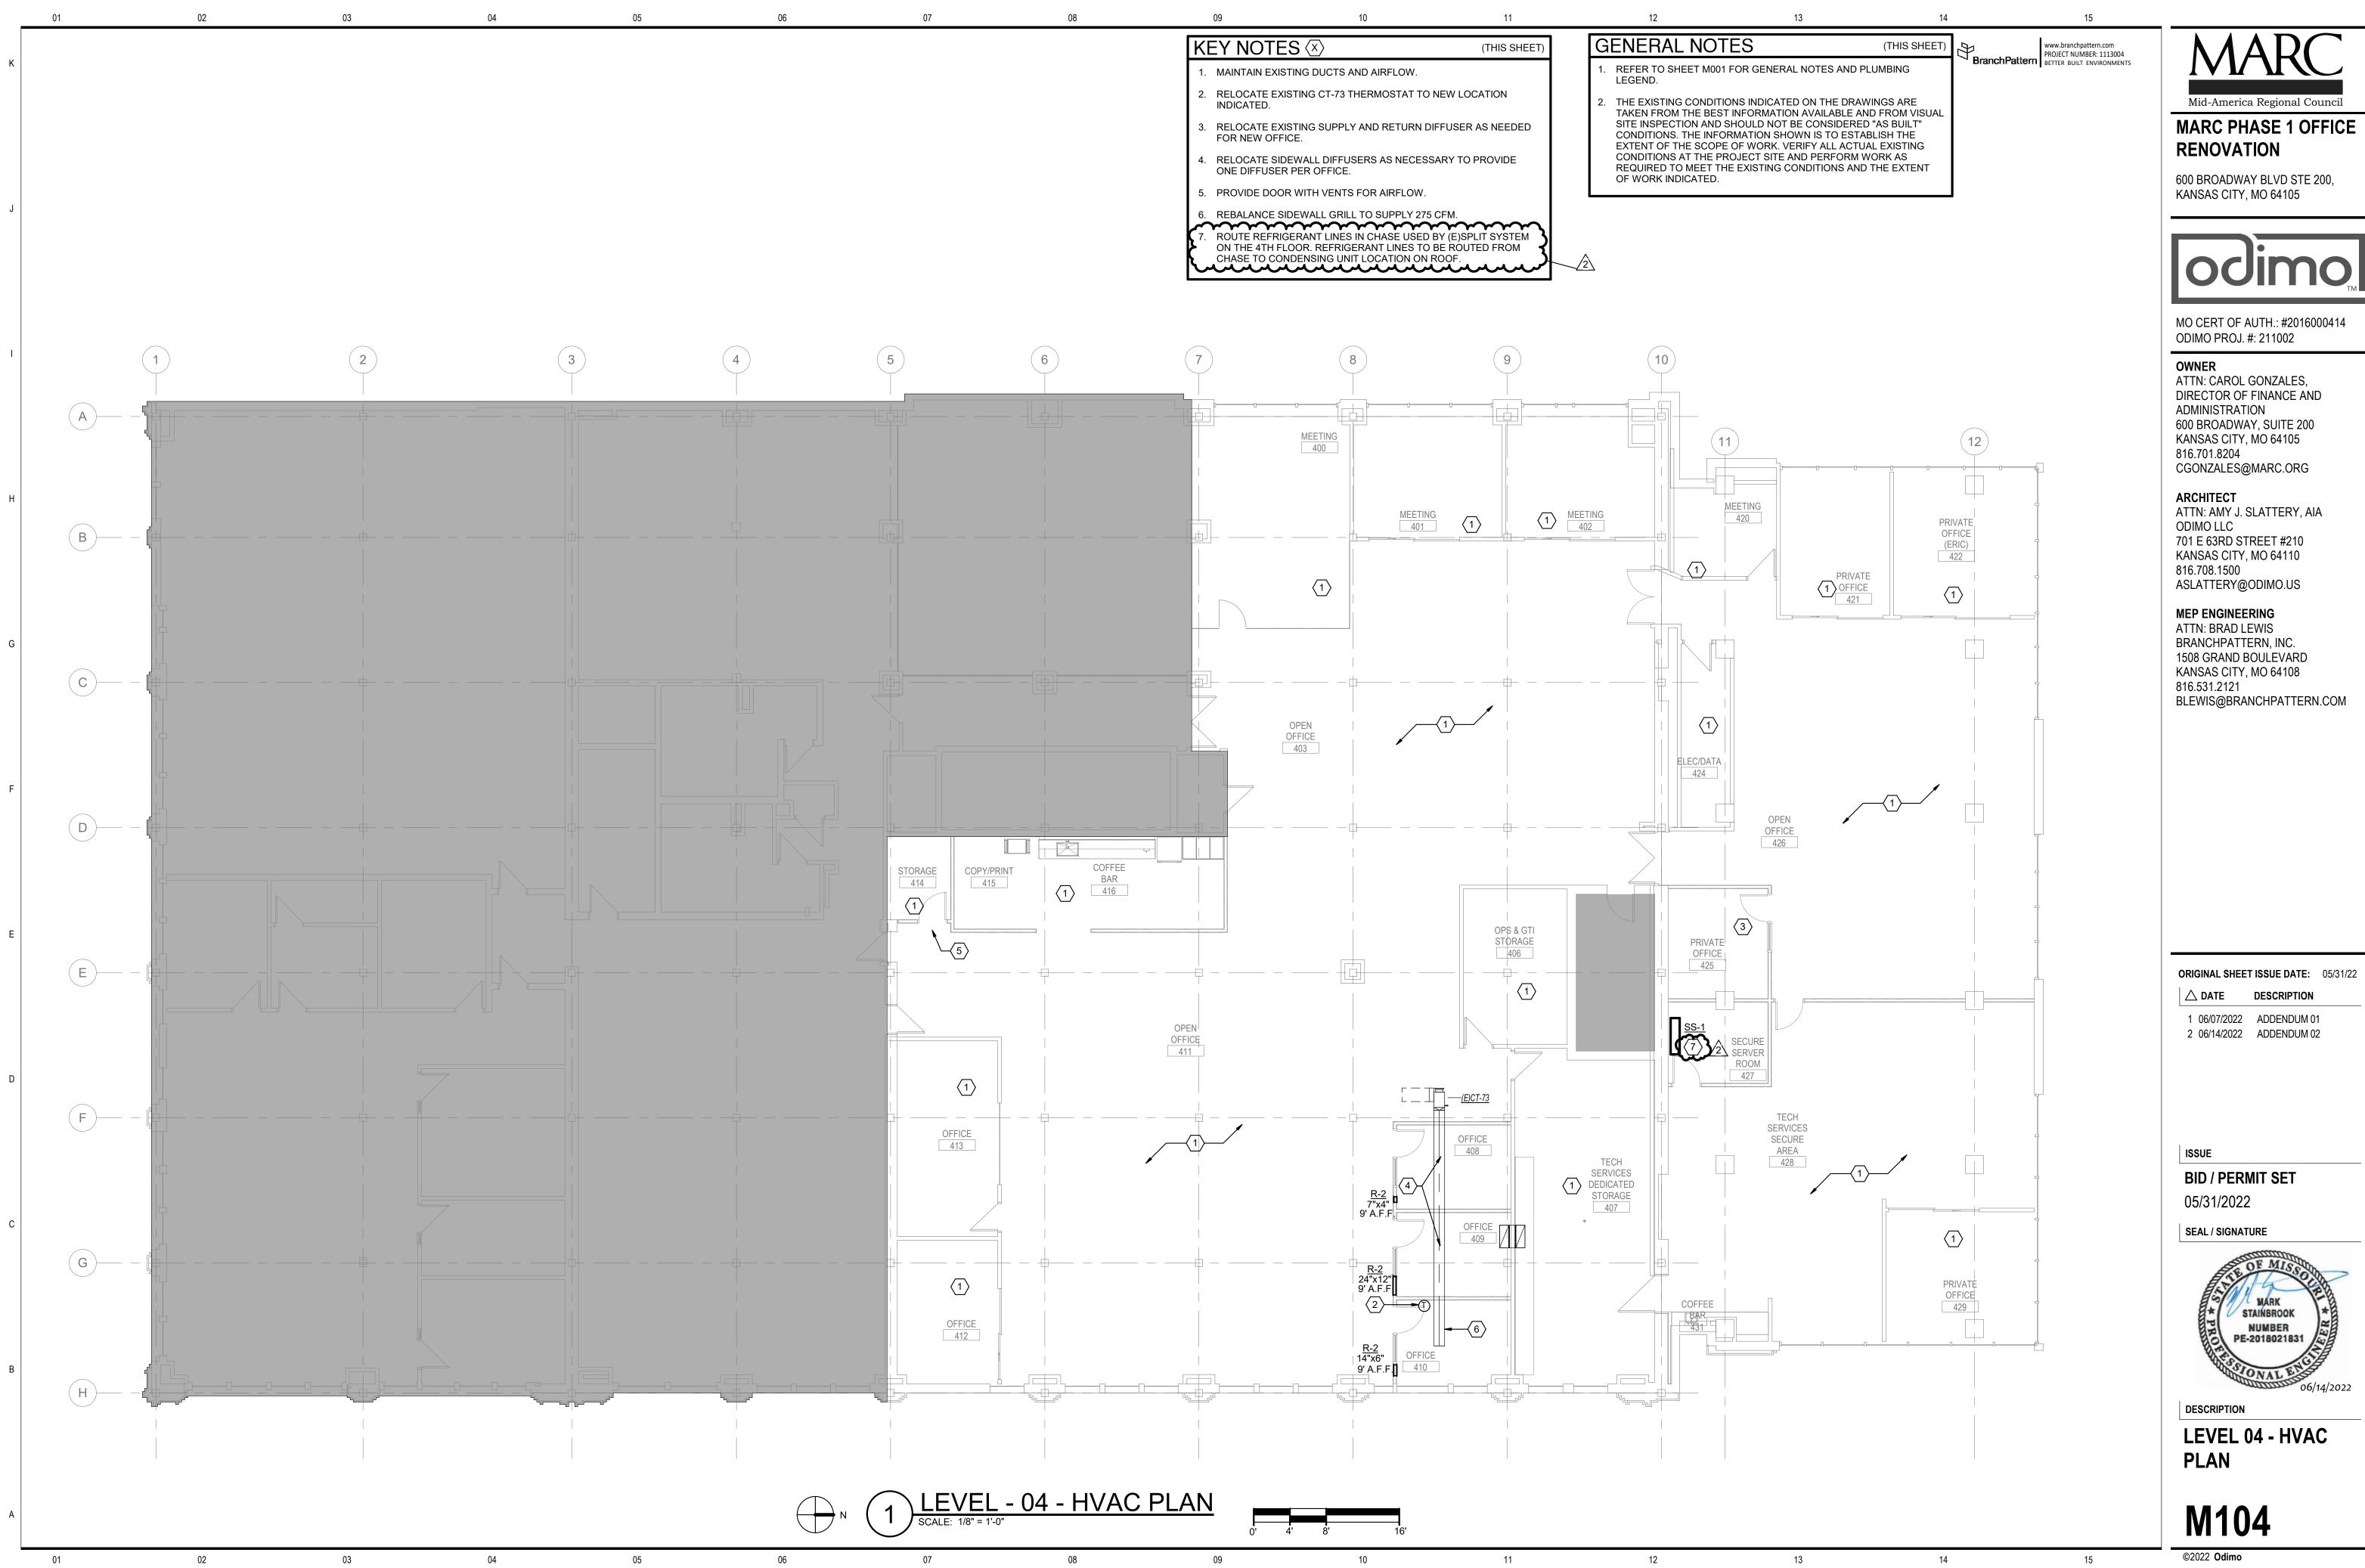

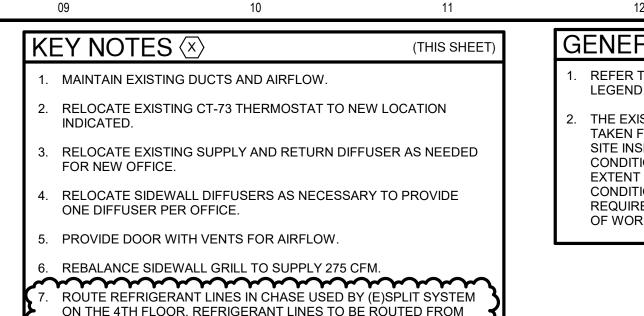

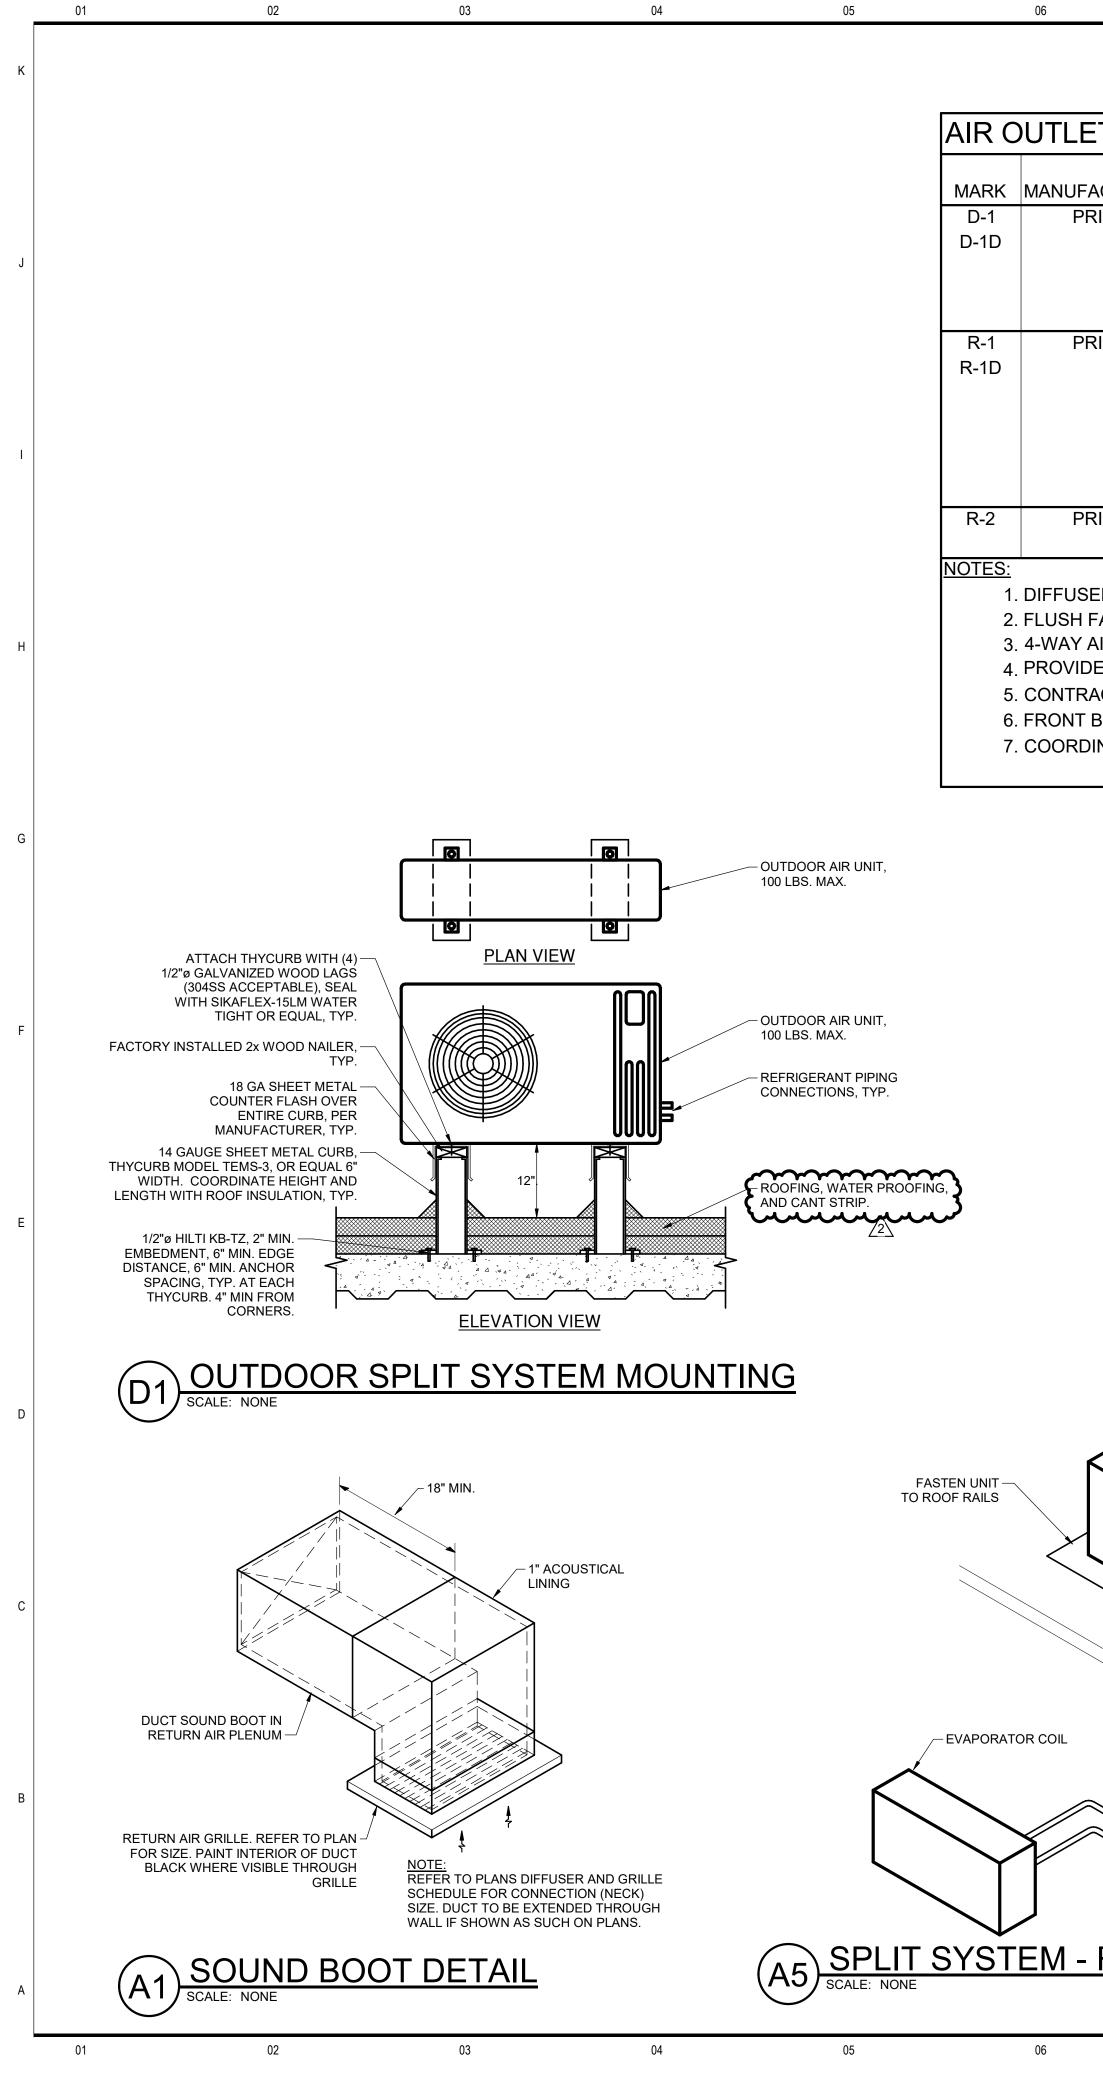

ET AND	INLET SCH	HEDULE									
				RUN-OUT	NECK	MAX				MAX T.S.P.	
FACTURER	MODEL	TYPE	MODULE SIZE	DIA. (IN.)	DIA. (IN.)	CFM	MATERIAL	BORDER	MAX NC	("WC)	NOTES
PRICE	ASPD	FULL FACE MODULE DIFFUSER	24"x24"	8	6	200	STAINLESS STEEL	LAY-IN OR SURFACE	25	0.1"	1,2,3,4,5,7
		DROPPED SQUARE PLAQUE		10	8	320		(REF: RCP)			
				12	10	400					
				14	12	475					
				16	14	560					
PRICE	APDDR	PERFORATED MODULE	24"x24"	6x6	6x6	120	STAINLESS STEEL	LAY-IN OR SURFACE	25	0.1"	1,2,4,5,7
		RETURN		8x8	8x8	260		(REF: RCP)			
				10x10	10x10	470					
				12x12	12x12	760					
				14x14	14x14	1140					
				16x16	16x16	1630					
				18x18	18x18	2220					
PRICE	80 EGGCRATE	SIDEWALL RETURN	SEE PLANS	SEE PLANS	SEE PLANS	SEE PLANS	STAINLESS STEEL	DUCT / SURFACE	25	0.1"	1,4,5,6,7
		GRILLE - 0° DEFLECTION									

1. DIFFUSER / GRILLE / REGISTER AND / OR ASSOCIATED PLENUM IS DUCTED.

2. FLUSH FACE PANEL

3. 4-WAY AIR THROW PATTERN, UNLESS STATED OTHERWISE.


4. PROVIDE WITH REMOTE DAMPER REGULATOR IN AREAS WITH INACCESSIBLE CEILINGS / WALLS (REFERENCE "D" SUFFIX MARK).

5. CONTRACTOR TO COORDINATE AND CONFIRM BORDER AND MOUNTING TYPE WITH ARCHITECTURAL PLANS PRIOR TO ORDERING.

6. FRONT BLADES PARALLEL TO FLOOR / DUCTWORK.

- CONDENSING UNIT

7. COORDINATE FINISH WITH ARCHITECT.

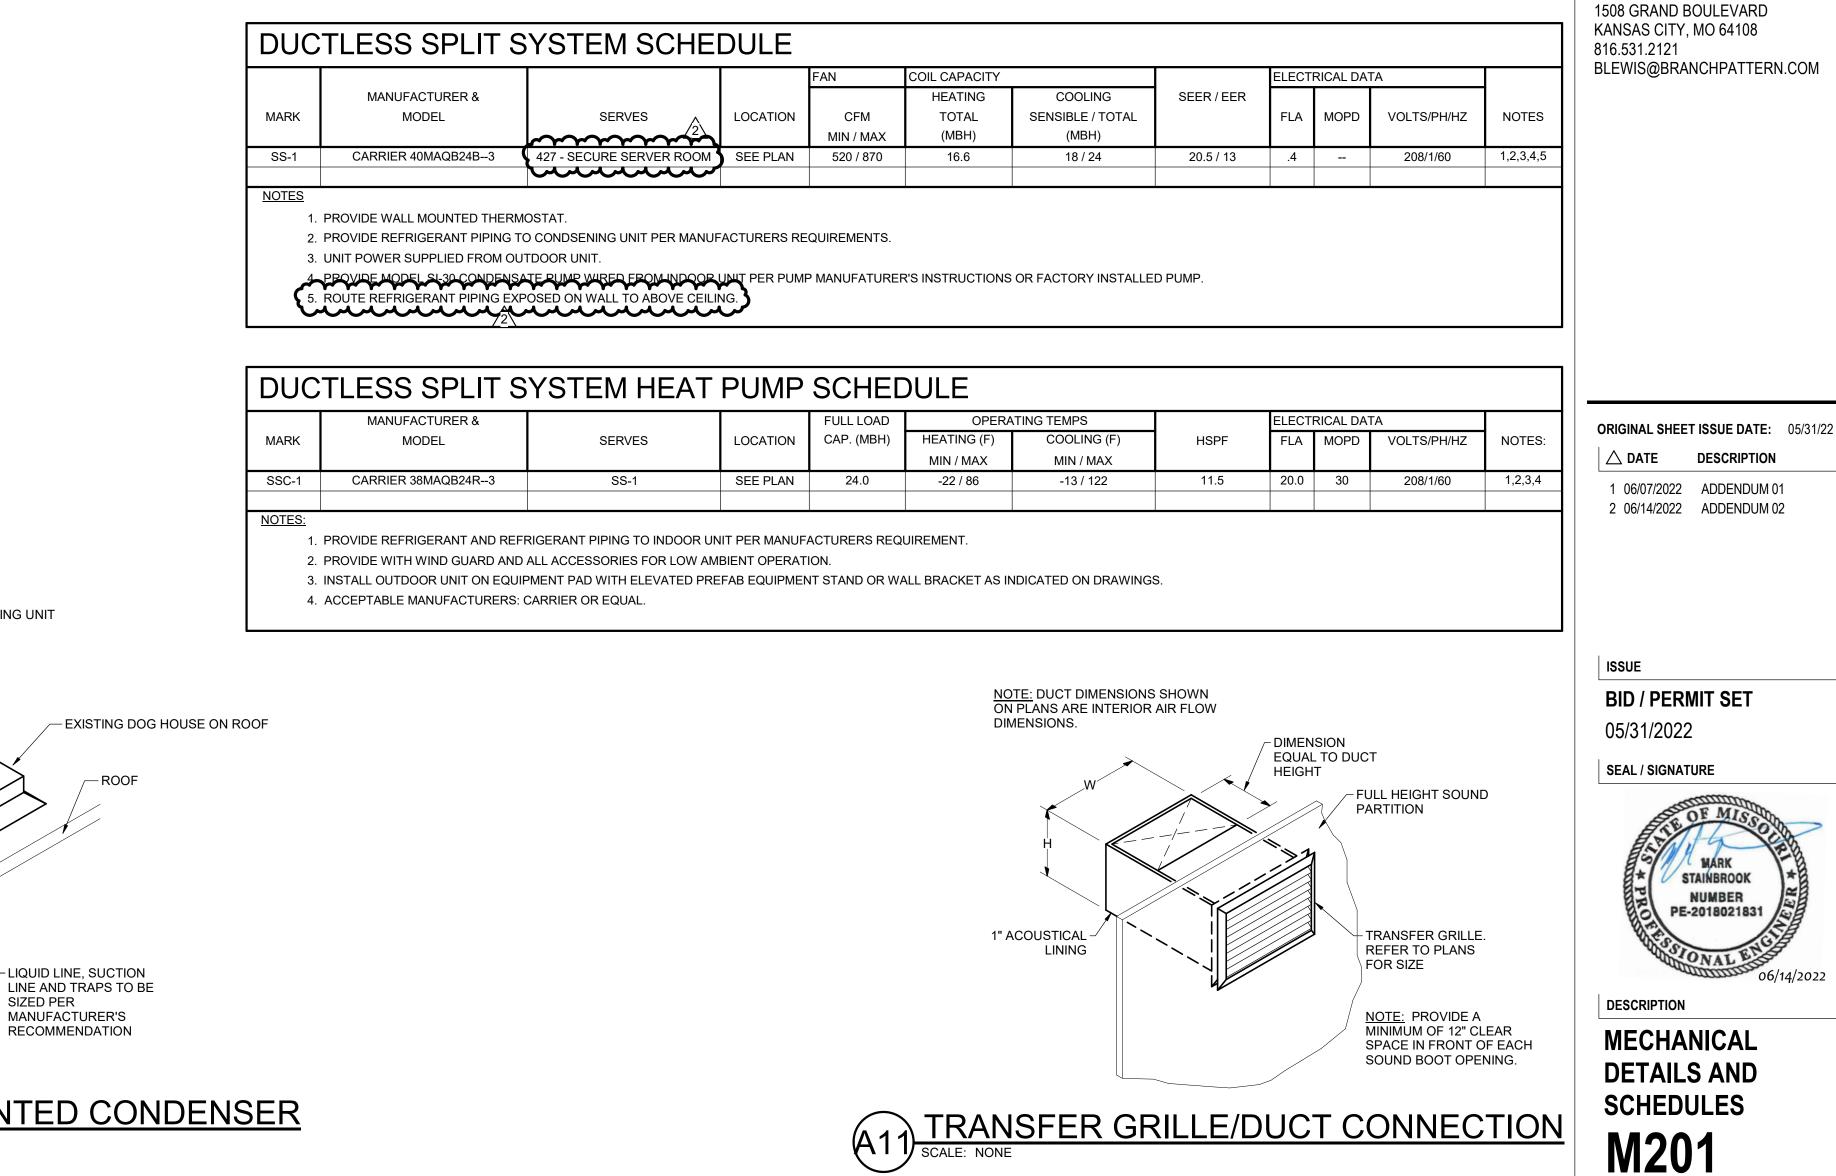

SPLIT SYSTEM - ROOF MOUNTED CONDENSER

SIZED PER



BranchPattern BUILT ENVIRONMENTS

Mid-America Regional Council

MARC PHASE 1 OFFICE

600 BROADWAY BLVD STE 200,

MO CERT OF AUTH.: #2016000414

ODIMO PROJ. #: 211002

ATTN: CAROL GONZALES, DIRECTOR OF FINANCE AND

600 BROADWAY, SUITE 200 KANSAS CITY, MO 64105

CGONZALES@MARC.ORG

ATTN: AMY J. SLATTERY, AIA

701 E 63RD STREET #210

KANSAS CITY, MO 64110

ASLATTERY@ODIMO.US

MEP ENGINEERING ATTN: BRAD LEWIS BRANCHPATTERN, INC.

ADMINISTRATION

816.701.8204

ARCHITECT


ODIMO LLC

816.708.1500

OWNER

RENOVATION


KANSAS CITY, MO 64105

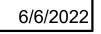

(ELECT				
	COOLING SENSIBLE / TOTAL (MBH)	SEER / EER	FLA	MOPD	VOLTS/PH/HZ	NOTES	
	18 / 24	20.5 / 13	.4		208/1/60	1,2,3,4,5	


TING TEMPS		ELECT	RICAL DA	ТА	
COOLING (F)	HSPF	FLA	MOPD	VOLTS/PH/HZ	NOTES:
MIN / MAX					
-13 / 122	11.5	20.0	30	208/1/60	1,2,3,4
	MIN / MAX	COOLING (F) HSPF MIN / MAX	COOLING (F) HSPF FLA MIN / MAX	COOLING (F) HSPF FLA MOPD MIN / MAX	COOLING (F) HSPF FLA MOPD VOLTS/PH/HZ MIN / MAX

©2022 Odimo

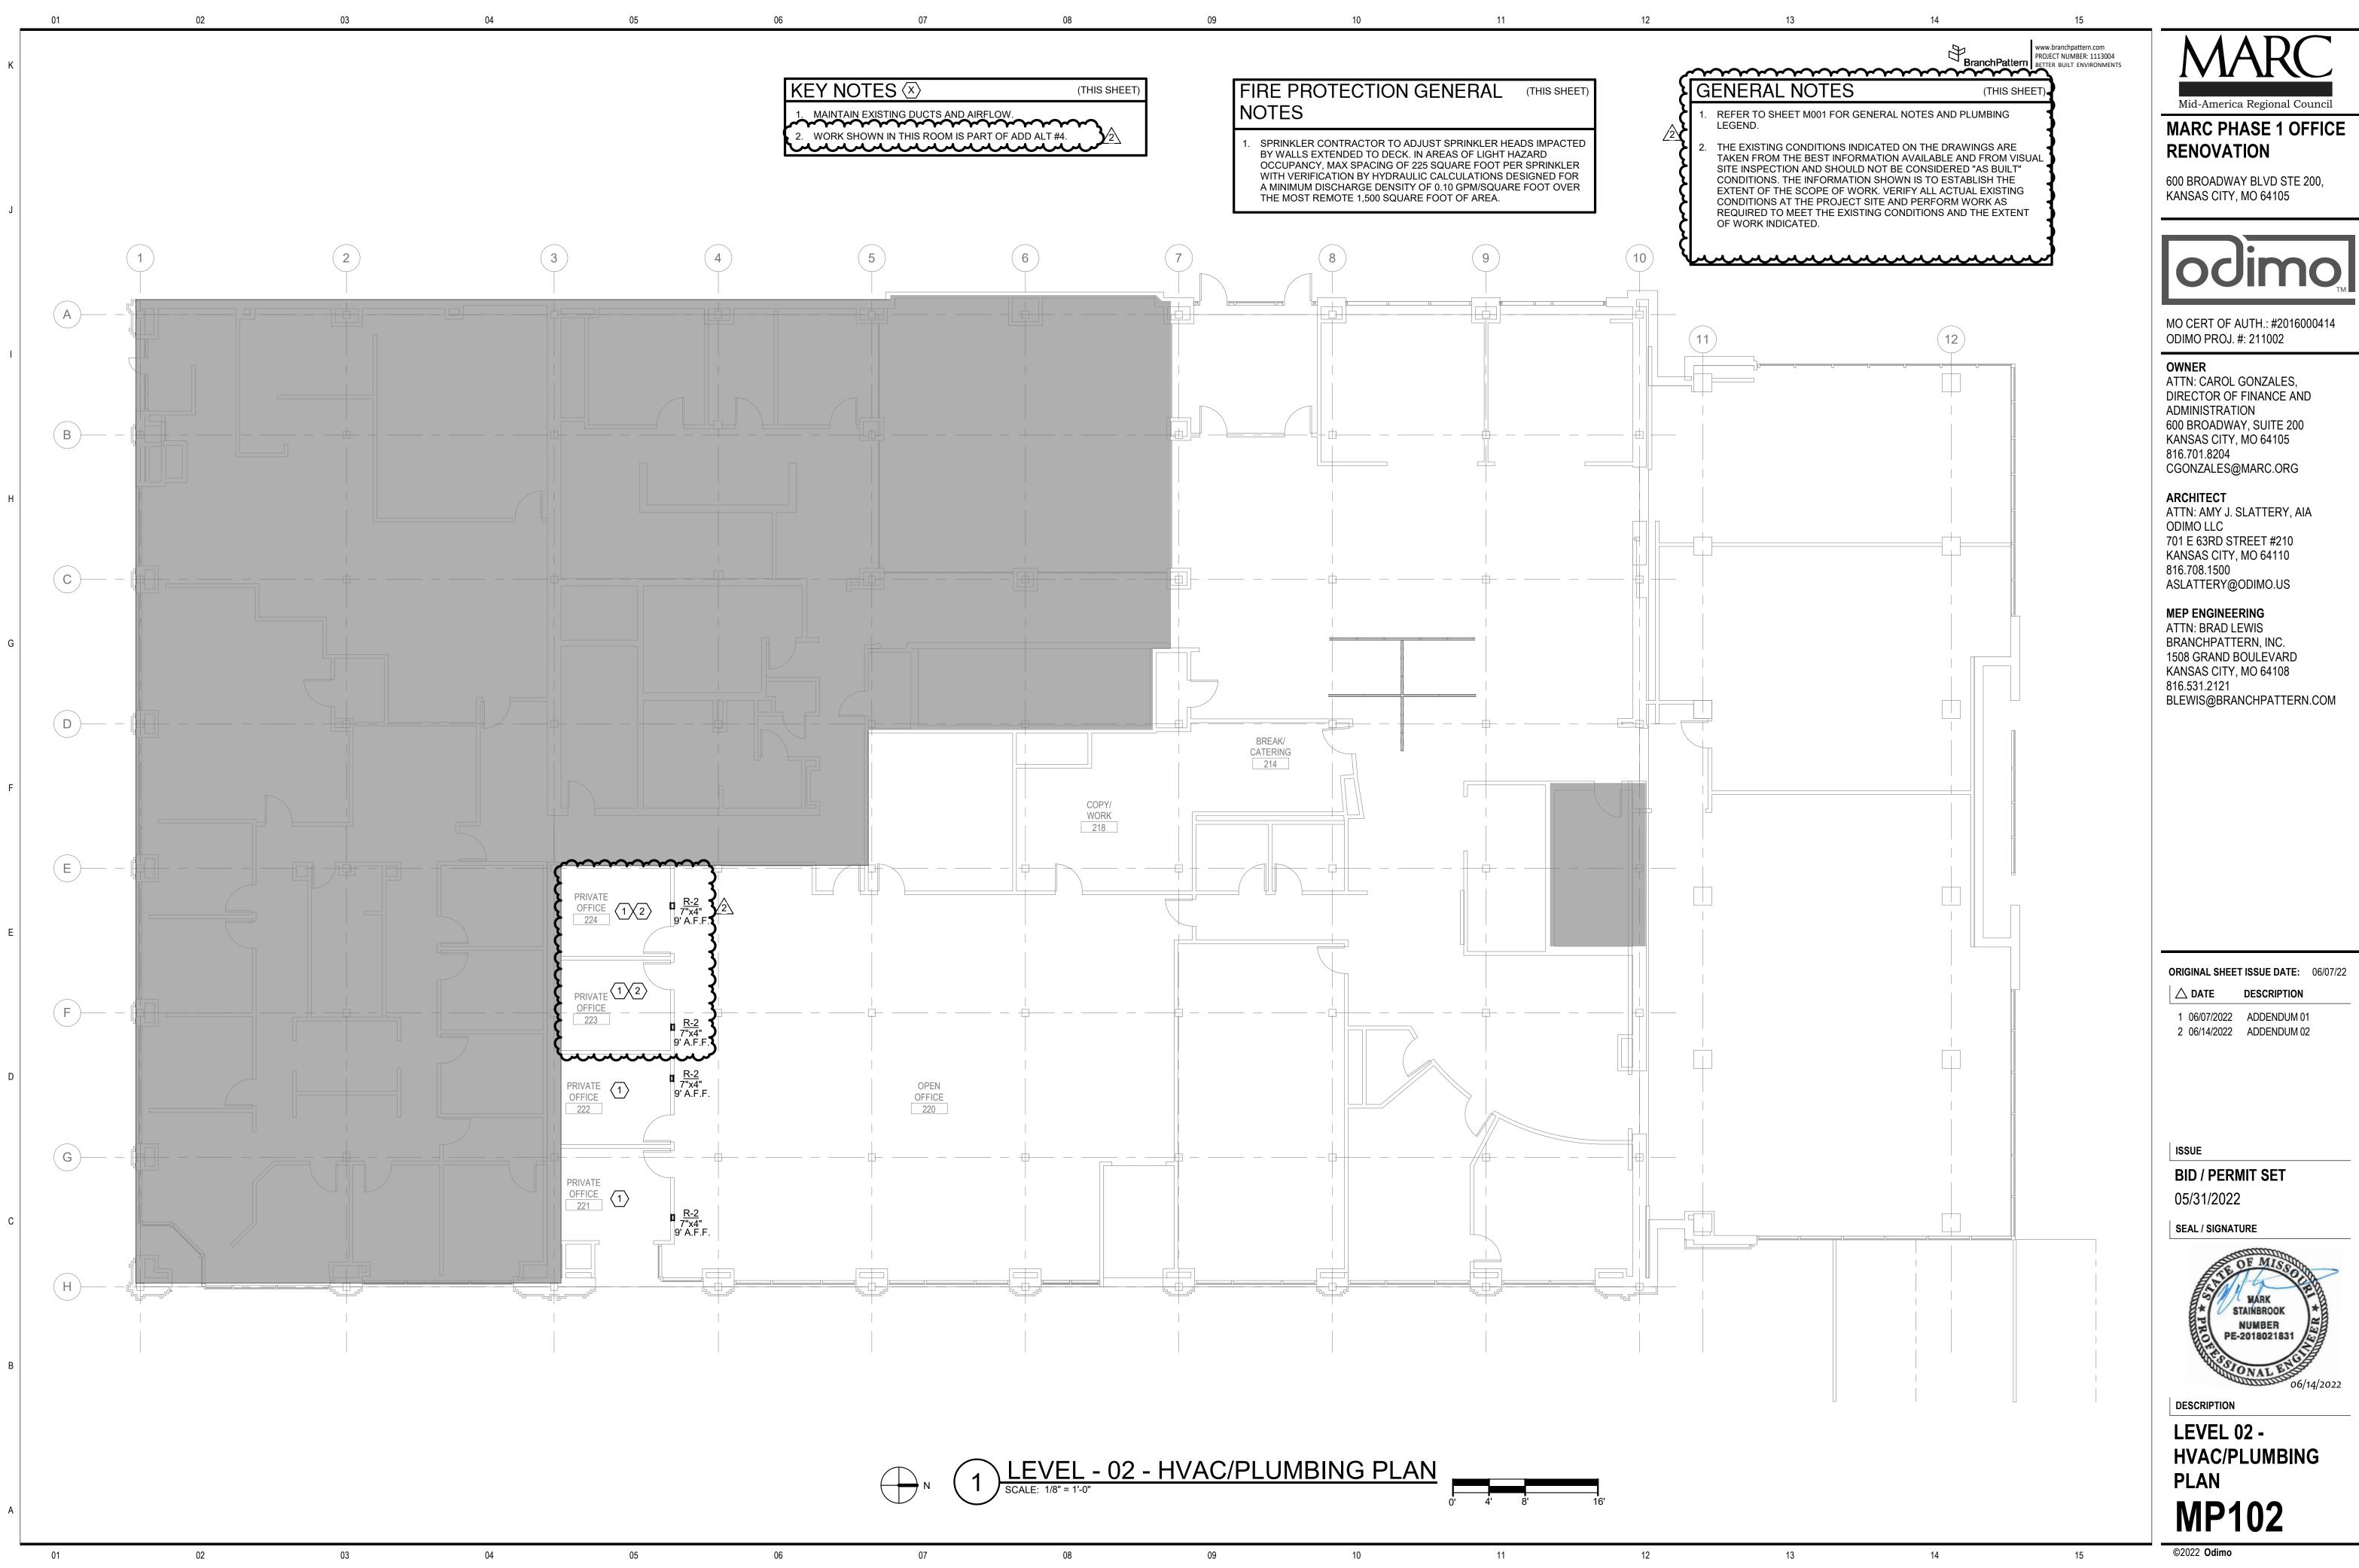

07	08	09	10	11	



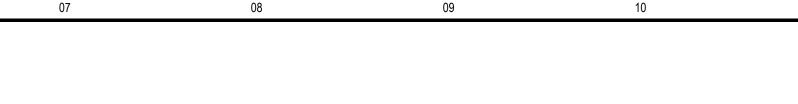

CONNECT TO NEAREST EXISTING COLD AND HOT WATER LINES IN

2. ADD ALT 3# - DEMOLISH EXISTING PLUMBING FIXTURES. CAP COLD

AND HOT WATER PIPES SERVING FIXTURE ABOVE CEILING AS

RESTROOM. CONNECT TO PIPE OF EQUAL OR GREATER SIZE. PROVIDE BRANCH SHUTOFF VALVES AT NEW CONNECTION INTO

(THIS SHEET

NOTES

KEY NOTES 🐼

EXISTING MAINS.




BY WALLS EXTENDED TO DECK. IN AREAS OF LIGHT HAZARD






15

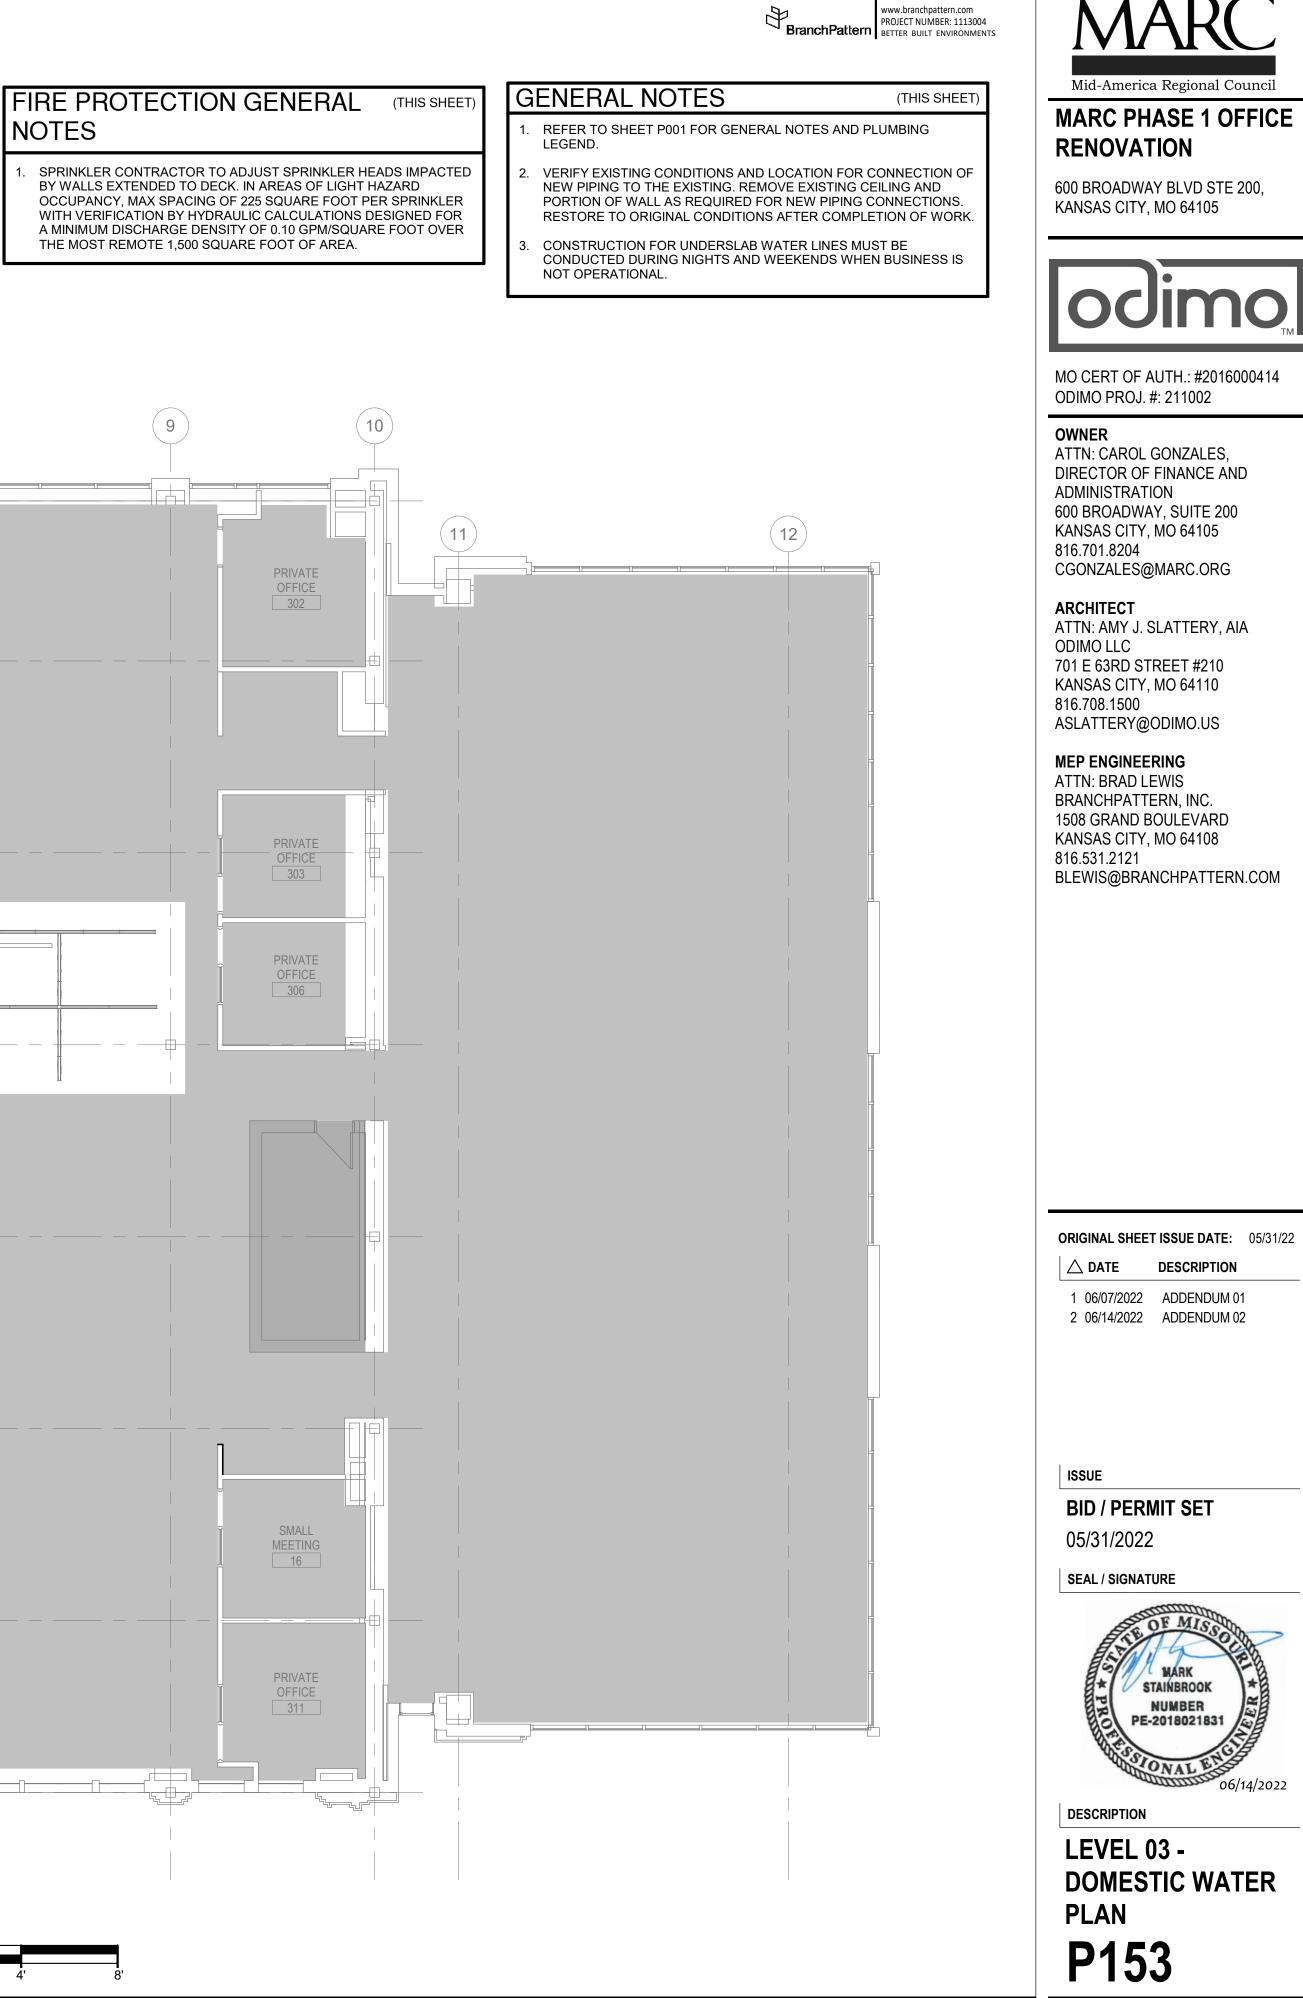


©2022 Odimo

15

14

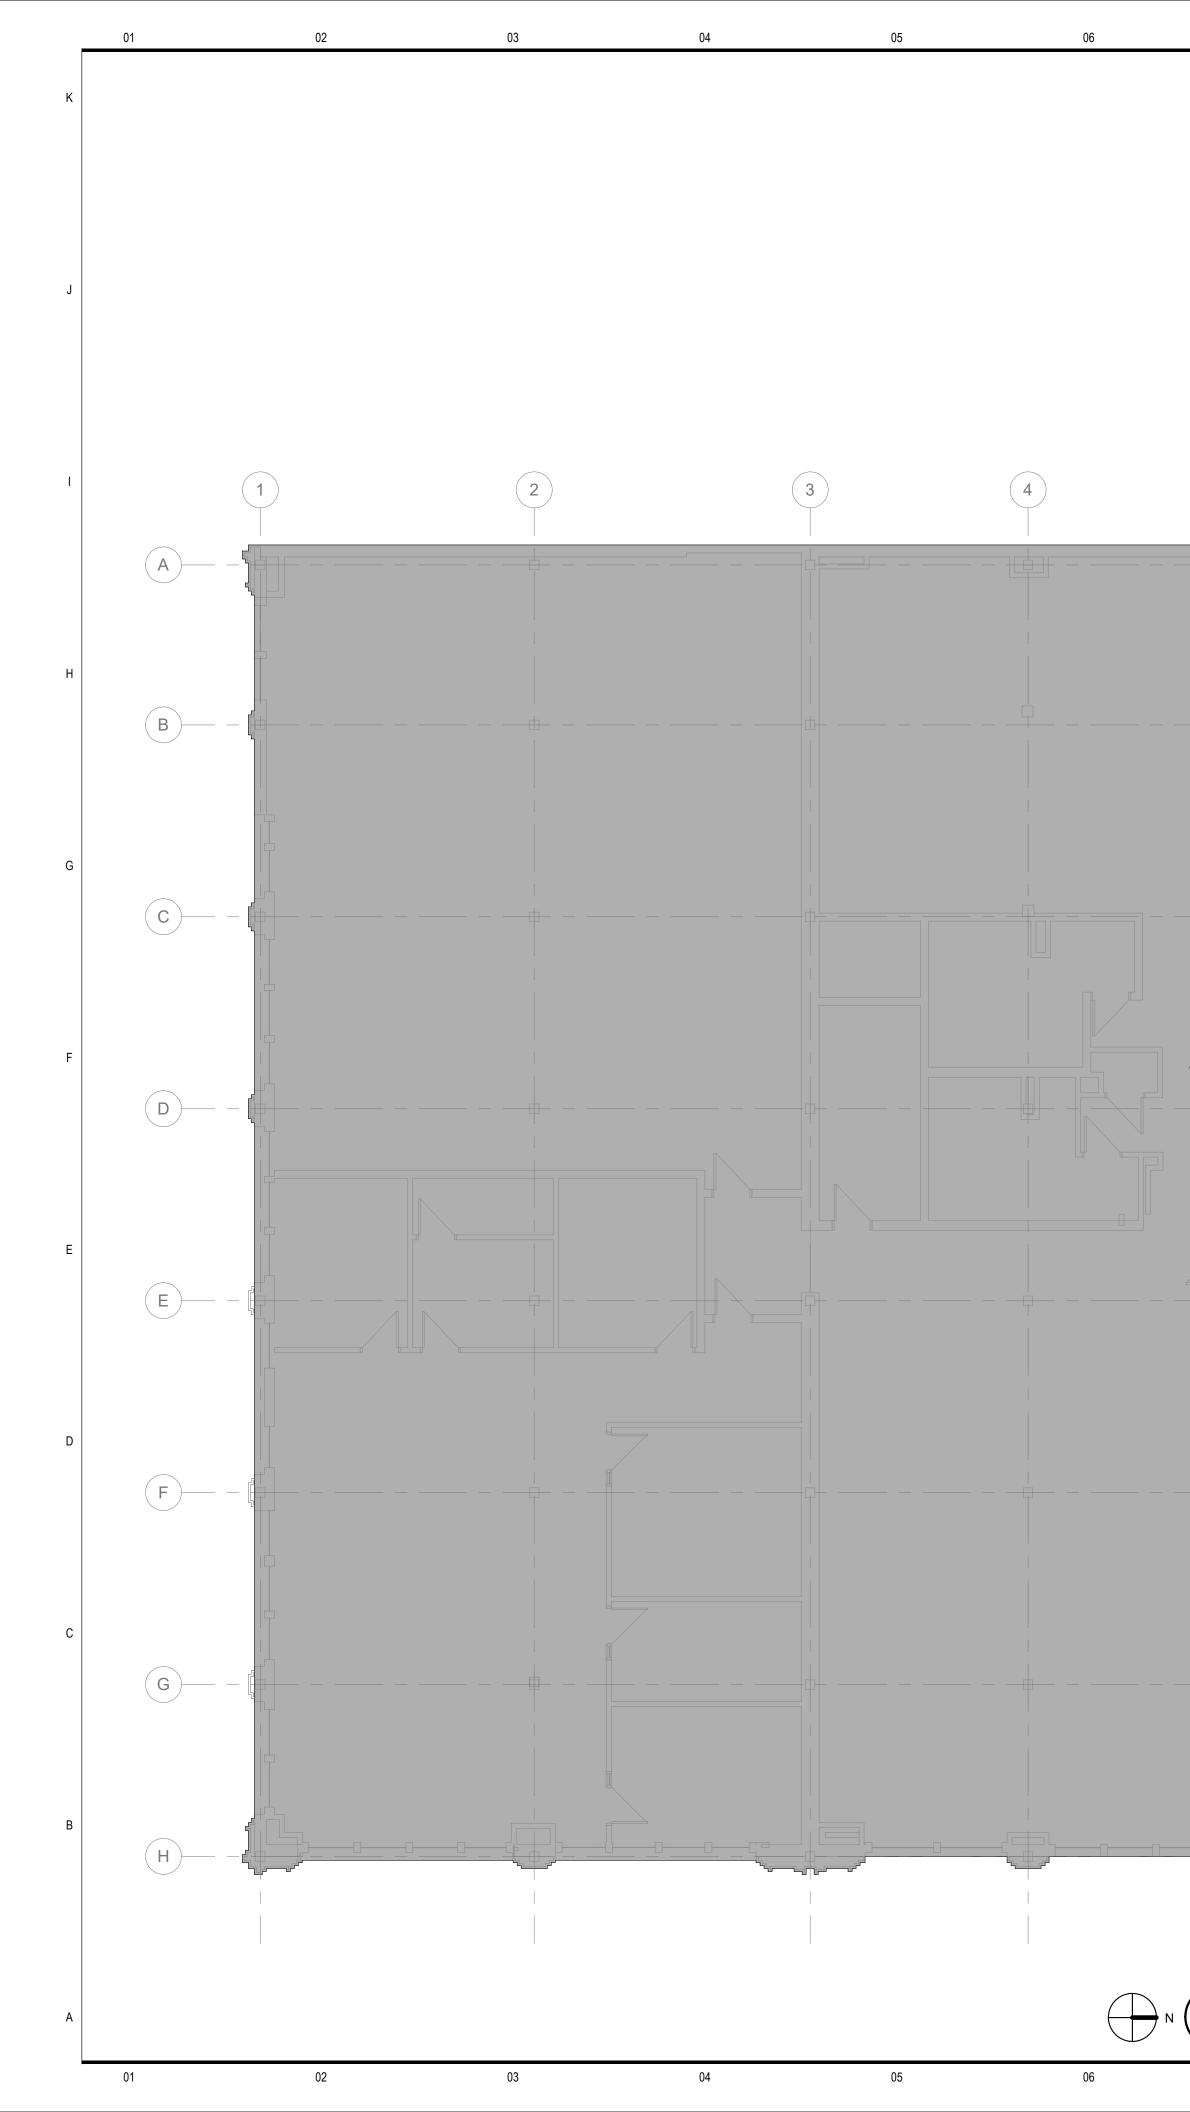



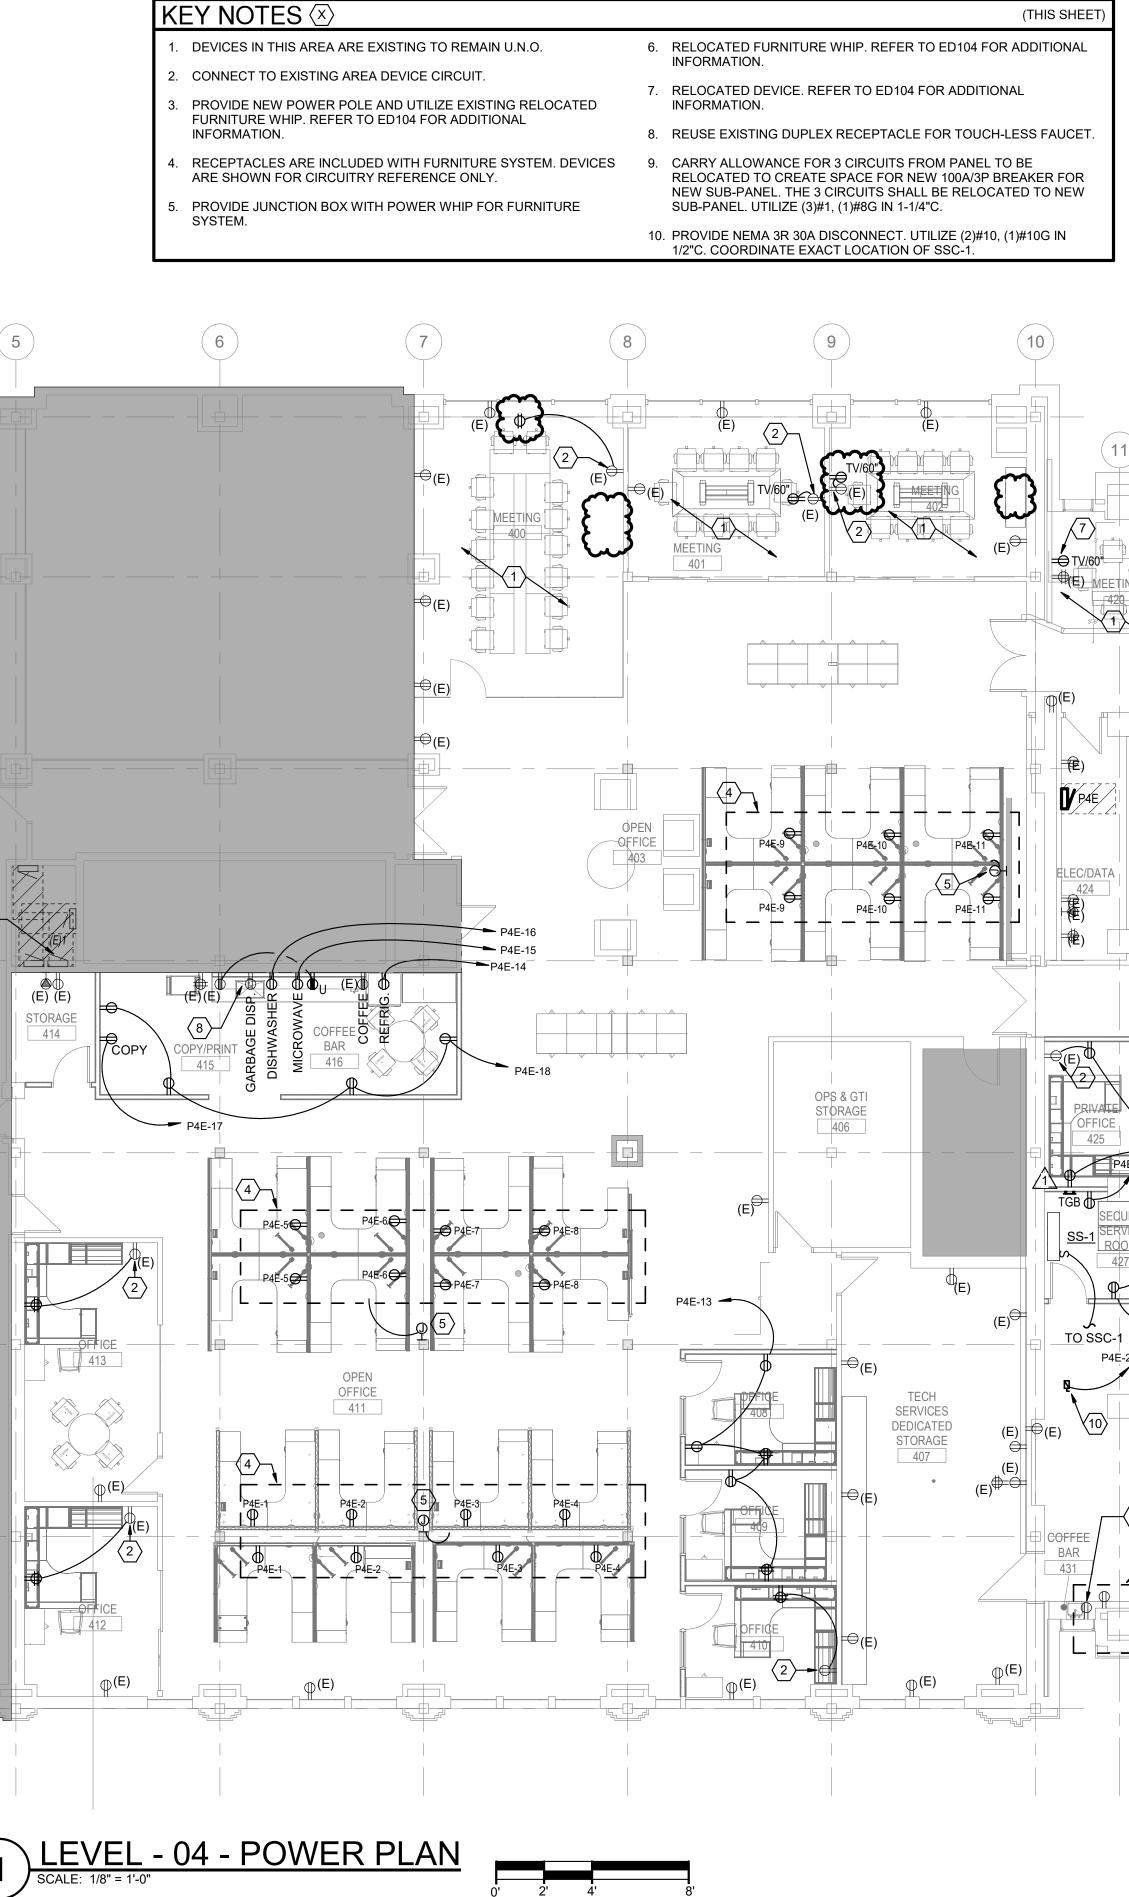


BranchPattern BUILT ENVIRONMENTS


(THIS SHEET)

GENERAL NOTES


REFER TO SHEET E001 FOR SYMBOLS LEGEND AND ADDITIONAL GENERAL NOTES.

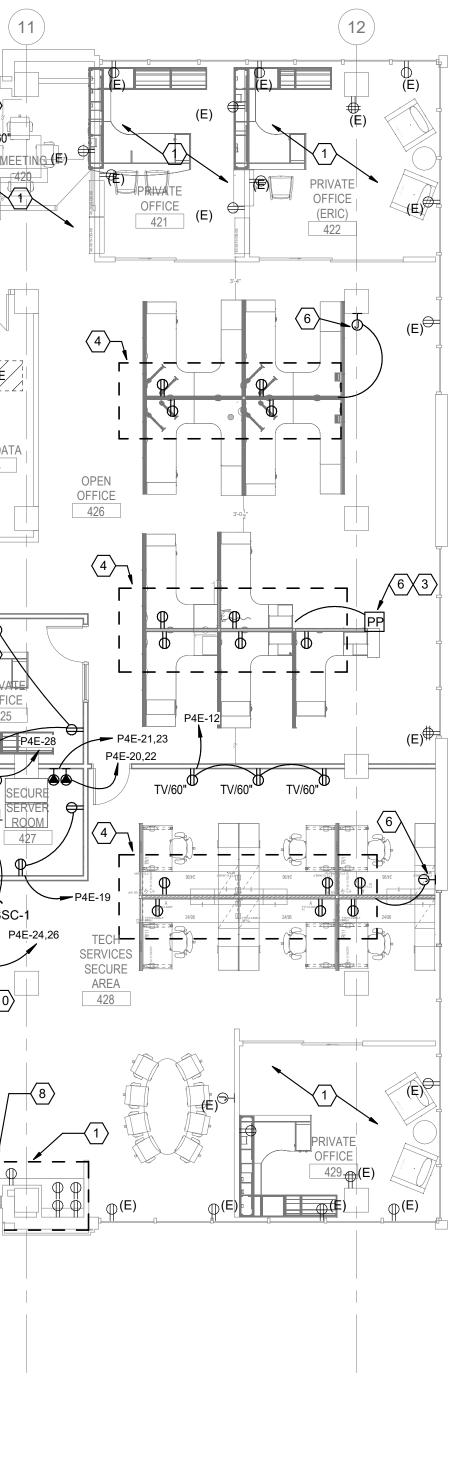




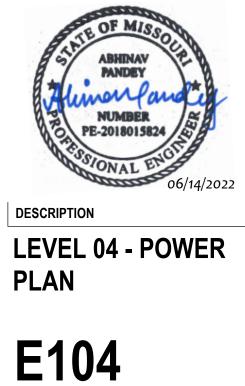

©2022 Odimo

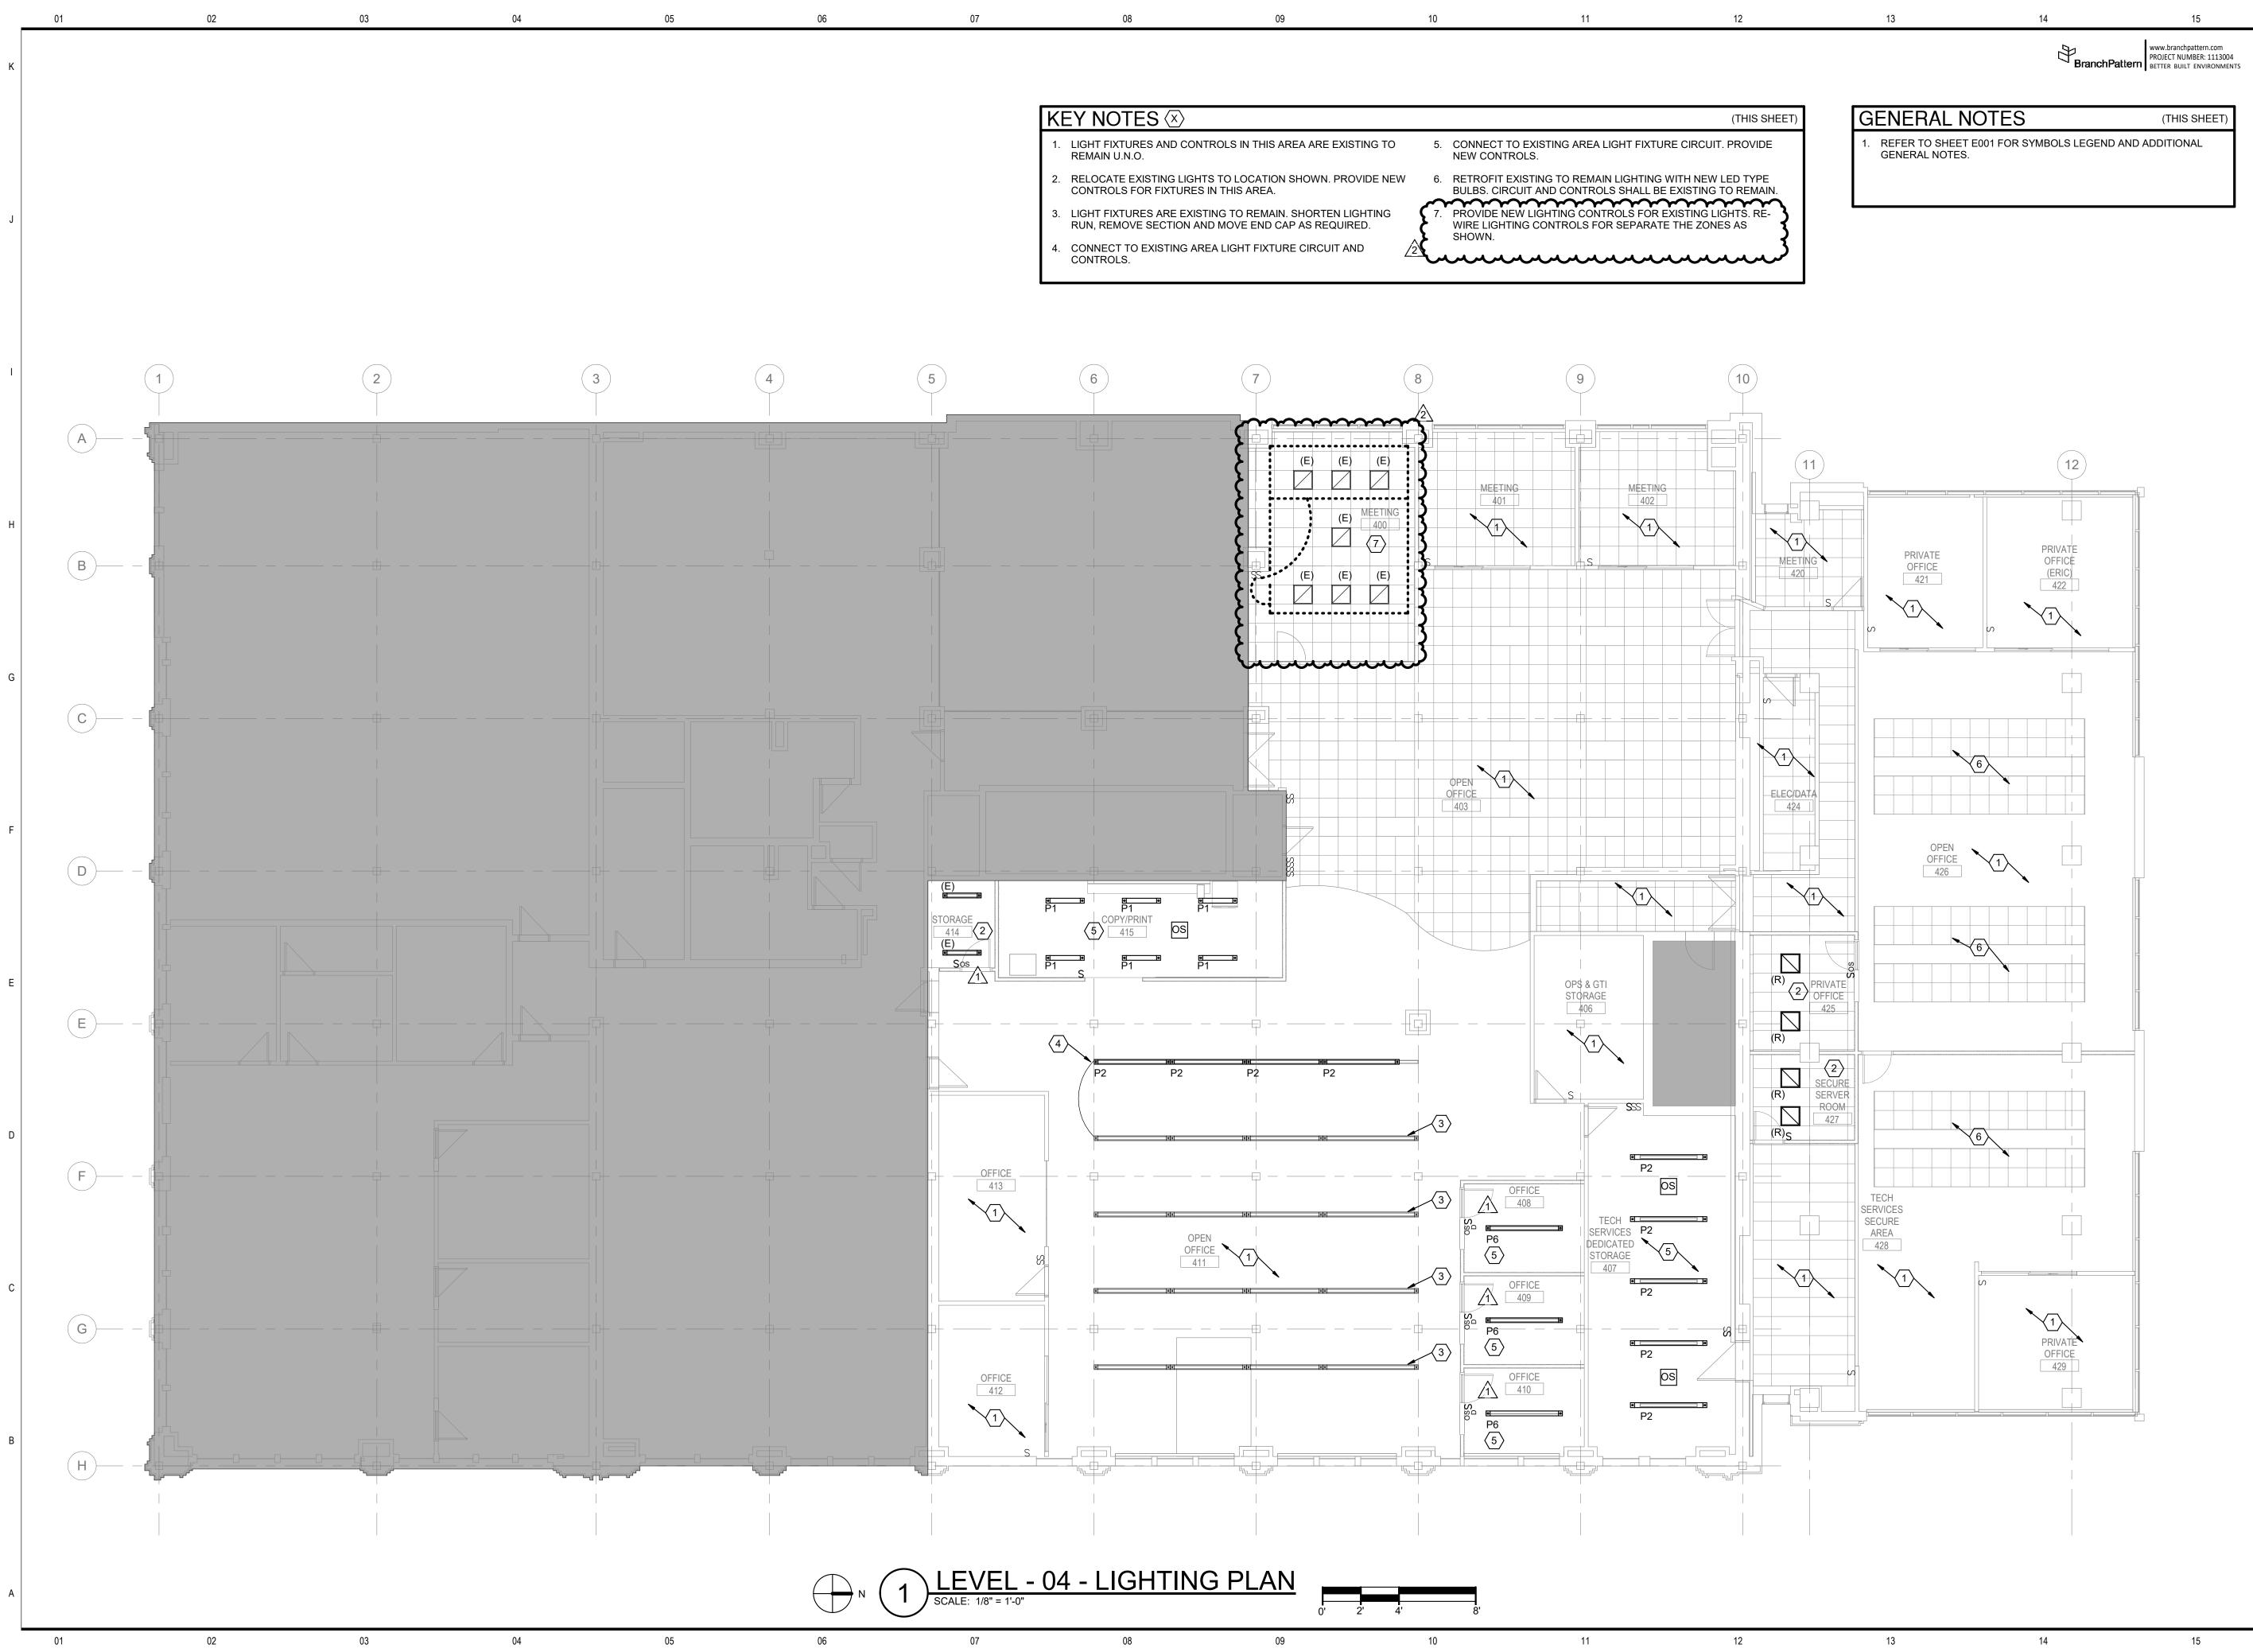

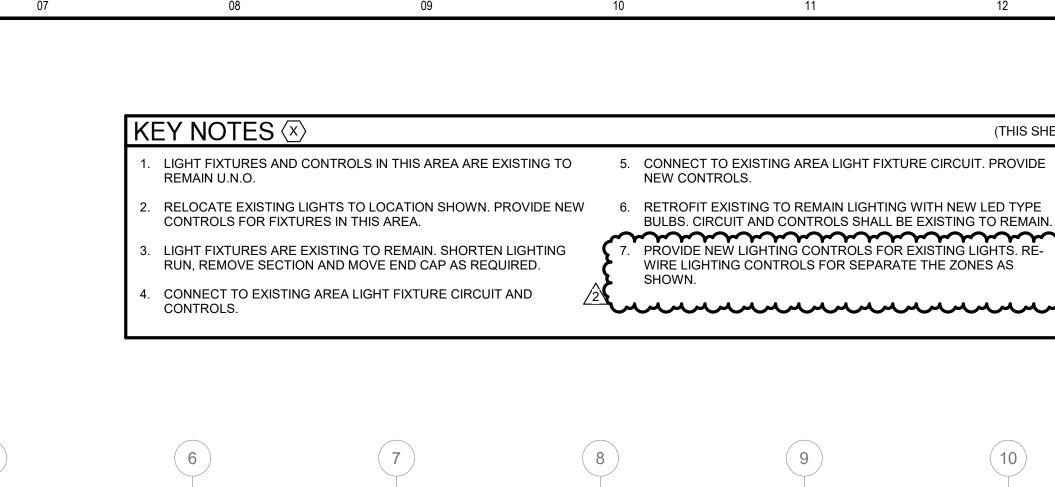

(THIS SHEET)

REFER TO SHEET E001 FOR SYMBOLS LEGEND AND ADDITIONAL



600 BROADWAY BLVD STE 200, KANSAS CITY, MO 64105



MO CERT OF AUTH.: #2016000414 ODIMO PROJ. #: 211002

OWNER

ATTN: CAROL GONZALES, DIRECTOR OF FINANCE AND ADMINISTRATION 600 BROADWAY, SUITE 200 KANSAS CITY, MO 64105 816.701.8204 CGONZALES@MARC.ORG

ARCHITECT

ATTN: AMY J. SLATTERY, AIA ODIMO LLC 701 E 63RD STREET #210 KANSAS CITY, MO 64110 816.708.1500 ASLATTERY@ODIMO.US

MEP ENGINEERING

ATTN: BRAD LEWIS BRANCHPATTERN, INC. 1508 GRAND BOULEVARD KANSAS CITY, MO 64108 816.531.2121 BLEWIS@BRANCHPATTERN.COM

ORIGI	NAL SHEE	T ISSUE DATE	E: 05/13/22
_ r	DATE	DESCRIPTIC	ON
ISSL			
BIC) / PERI	MIT SET	
05/	31/2022	<u>)</u>	
SEA	L / SIGNAT	URE	
	A LINE	OF MISSO ABHINAV PANDEY MUMBER 2018015824	06/14/2022
DES	CRIPTION		
	VEL (An)4 - LIG	HTING
		4	

01

01

02

03

04

05

06

07

08

09

10

11

SYIVIE	BOL TY	PES						ABBREVIATIONS
NOTE: THIS IS	A MASTER SYN	BOLS LIST. ALL SYMBOLS, ABBREVIATIONS, ETC. MAY NOT NECESSARILY BE USED	ON ALL DRAWINGS					AC ABOVE COUNTER AFF ABOVE FINISHED FLOOR
TELECOM SY	MBOLS							C CONDUIT CFCI CONTRACTOR FURNISHED AND CONTRACTOR
XX TELEC	OM DATA DEVICI TO SCHEDULE I	E MOUNTED ON WALL. XX INDICATES TYPE, BELOW FOR DEVICE INFORMATION.	IOUNTED ON FLOOR. XX INDICATES 1 LOW FOR DEVICE INFORMATION.	TYPE, XX TELECOM DATA DEVICE MOUNTED ON CEILING. XX REFER TO SCHEDULE BELOW FOR DEVICE INFORM	INDICATES TYPE, XX TELECOM ANALOG DEVICE MOUNTED IATION. ∇ REFER TO SCHEDULE BELOW FOR DE	ON WALL. XX INDICA ⁻ VICE INFORMATION.	TES TYPE,	CFOI CONTRACTOR FURNISHED AND OWNER INSTAL (E) EXISTING
			E MOUNTED ON CEILING. XX INDICAT					EF ENTRANCE FACILITY ER EQUIPMENT ROOM
XX			ILE BELOW FOR DEVICE INFORMATIO	N. V XX INDICATES TYPE, REFER TO SCHEDULE BELOW INFORMATION.	FOR DEVICE XX INDICATES TYPE, REFER TO SCHED	DULE BELOW FOR DE	VICE	GND GROUND
CEILIN		G COMBINATION DEVICE MOUNTED ON TYPE, REFER TO SCHEDULE BELOW FOR						LAN LOCAL AREA NETWORK LC LUCENT CONNECTOR
AV SYMBOLS								Mbps MEGABITS PER SECOND MM MULTIMODE
Y SCHED	ULE BELOW FOR	ON WALL. XX INDICATES TYPE, REFER TO R DEVICE INFORMATION. ON CEILING. XX INDICATES TYPE, REFER TO	FLOOR. XX INDICATES TYPE, REFER DEVICE INFORMATION.	TO AV DEVICE MOUNTED ON CEILING. XX INDICATES T SCHEDULE BELOW FOR DEVICE INFORMATION.	YPE, REFER TO \bigotimes AV CAMERA MOUNTED ON WALL. XX IN SCHEDULE BELOW FOR DEVICE INFOR		ER TO	OFCI OWNER FURNISHED AND CONTRACTOR INSTAL OFOI OWNER FURNISHED AND OWNER INSTALLED OSP OUTSIDE CABLE PLANT
		R DEVICE INFORMATION.						PBB PRIMARY BONDING BUSBAR PoE POWER OVER ETHERNET PoE+ POWER OVER ETHERNET PLUS
SECURITY SY		INTED ON WALL. XX INDICATES TYPE, REFER SECURITY DEVICE MOUNT	TED ON FLOOR. XX INDICATES TYPE,		CATES TYPE, REFER 💮 SECURITY CAMERA MOUNTED ON WAI	LL. XX INDICATES TYP	PE. REFFR	RU RACK UNIT (1.75")
	HEDULE BELOW	FOR DEVICE INFORMATION. TO SCHEDULE BELOW FOI		TO SCHEDULE BELOW FOR DEVICE INFORMATION.	TO SCHEDULE BELOW FOR DEVICE INI		, .	QTY QUANTITY SBB SECONDARY BONDING BUSBAR
	TO SCHEDULE I	BELOW FOR DEVICE INFORMATION.						SEF SERVICE ENTRANCE FACILITY SM SINGLE MODE
AUDIOVISUAL		TYPE DESCRIPTION D DISPLAY AV CONNECTION		INFRASTRUCTURE BOX 4-11/16 SQUARE WITH 1-DEVICE MUD RING, FLUSH MOUNTED, 2-1/8"	INFRASTRUCTURE CONDUIT	REFERENCE		TIA TELECOMMUNICATIONS INDUSTRY ASSOCIATION TYP TYPICAL
mm.	mu	D DISPLAY AV CONNECTION D DISPLAY AV CONNECTION		4-11/10 SQUARE WITH I-DEVICE MUD RING. FLUSH MUUNTED. 2-1/0			<u> </u>	UG UNDERGROUND UNO UNLESS OTHERWISE NOTED UPS UNINTERRUPTIBLE POWER SUPPLY
			min	DEEP BACK BOX			I	UTP UNSHIELDED TWISTED PAIR W/ WITH
DATA DEVICE	WALL	1 1-PORT TELECOM OUTLET 2 2-PORT TELECOM OUTLET	1' - 6" AFF 1' - 6" AFF	DEEP BACK BOX 4-11/16" SQUARE WITH 1-DEVICE MUD RING, FLUSH MOUNTED, 2-1/8" DEEP BACK BOX	(1) 1" C TO ACCESSIBLE CEILING SPACE OR CABLE TRAY (1) 1" C TO ACCESSIBLE CEILING SPACE OR CABLE TRAY		43 70	W/O WITHOUT WAO WORK AREA OUTLET WAP WIRELESS ACCESS POINT
DATA DEVICE	WALL	4 4-PORT TELECOM OUTLET	1' - 6" AFF	4-11/16" SQUARE WITH 1-DEVICE MUD RING, FLUSH MOUNTED, 2-1/8" DEEP BACK BOX	(1) 1" C TO ACCESSIBLE CEILING SPACE OR CABLE TRAY		6	XC CROSS-CONNECT
DATA DEVICE SECURITY	WALL	6 6-PORT TELECOM OUTLET R CARD READER	1' - 6" AFF 3' - 10" AFF	 4-11/16" SQUARE WITH 1-DEVICE MUD RING, FLUSH MOUNTED, 2-1/8" DEEP BACK BOX 4-11/16" SQUARE WITH 1-DEVICE MUD RING, FLUSH MOUNTED, 2-1/8" 		E	4	
			0 - 10 AT	DEEP BACK BOX	TRAY			EQUIPMENT LEGEND
								FLAT PANEL DISPLAY, REF
								PROJECTION SCREEN, REF TO DISPLAY TABLE BELOW ANNOTATION DESCRIPTION
								4-POST RACK
								2-POST RACK
								WALL PANEL, "XX" INDICATE XX TYPE, CHECK ABBREVIATION
								LIST FOR TYPE.
								TECHNOLOGY SHEET
								T001TECHNOLOGY LEGENDT002TECHNOLOGY NOTEST103LEVEL 03 - TECHNOLOGY PLAN
								T001TECHNOLOGY LEGENDT002TECHNOLOGY NOTES

05

08

07

09

10

www.branchpattern.com PROJECT NUMBER: 1113004 BETTER BUILT ENVIRONMENTS

12



RENOVATION

600 BROADWAY BLVD STE 200, KANSAS CITY, MO 64105



MO CERT OF AUTH.: #2016000414 ODIMO PROJ. #: 211002

OWNER

ATTN: CAROL GONZALES, DIRECTOR OF FINANCE AND ADMINISTRATION 600 BROADWAY, SUITE 200 KANSAS CITY, MO 64105 816.701.8204 CGONZALES@MARC.ORG

ARCHITECT

ATTN: AMY J. SLATTERY, AIA ODIMO LLC 701 E 63RD STREET #210 KANSAS CITY, MO 64110 816.708.1500 ASLATTERY@ODIMO.US

MEP ENGINEERING

ATTN: BRAD LEWIS BRANCHPATTERN, INC. 1508 GRAND BOULEVARD KANSAS CITY, MO 64108 816.531.2121 BLEWIS@BRANCHPATTERN.COM

ORIGINAL SHEET ISSUE DATE: 05/12/22					
	DESCRIPTION				
2 06/14/2022	ADDENDUM 02				

ISSUE


BID / PERMIT SET 05/31/2022

SEAL / SIGNATURE






©2022 Odimo

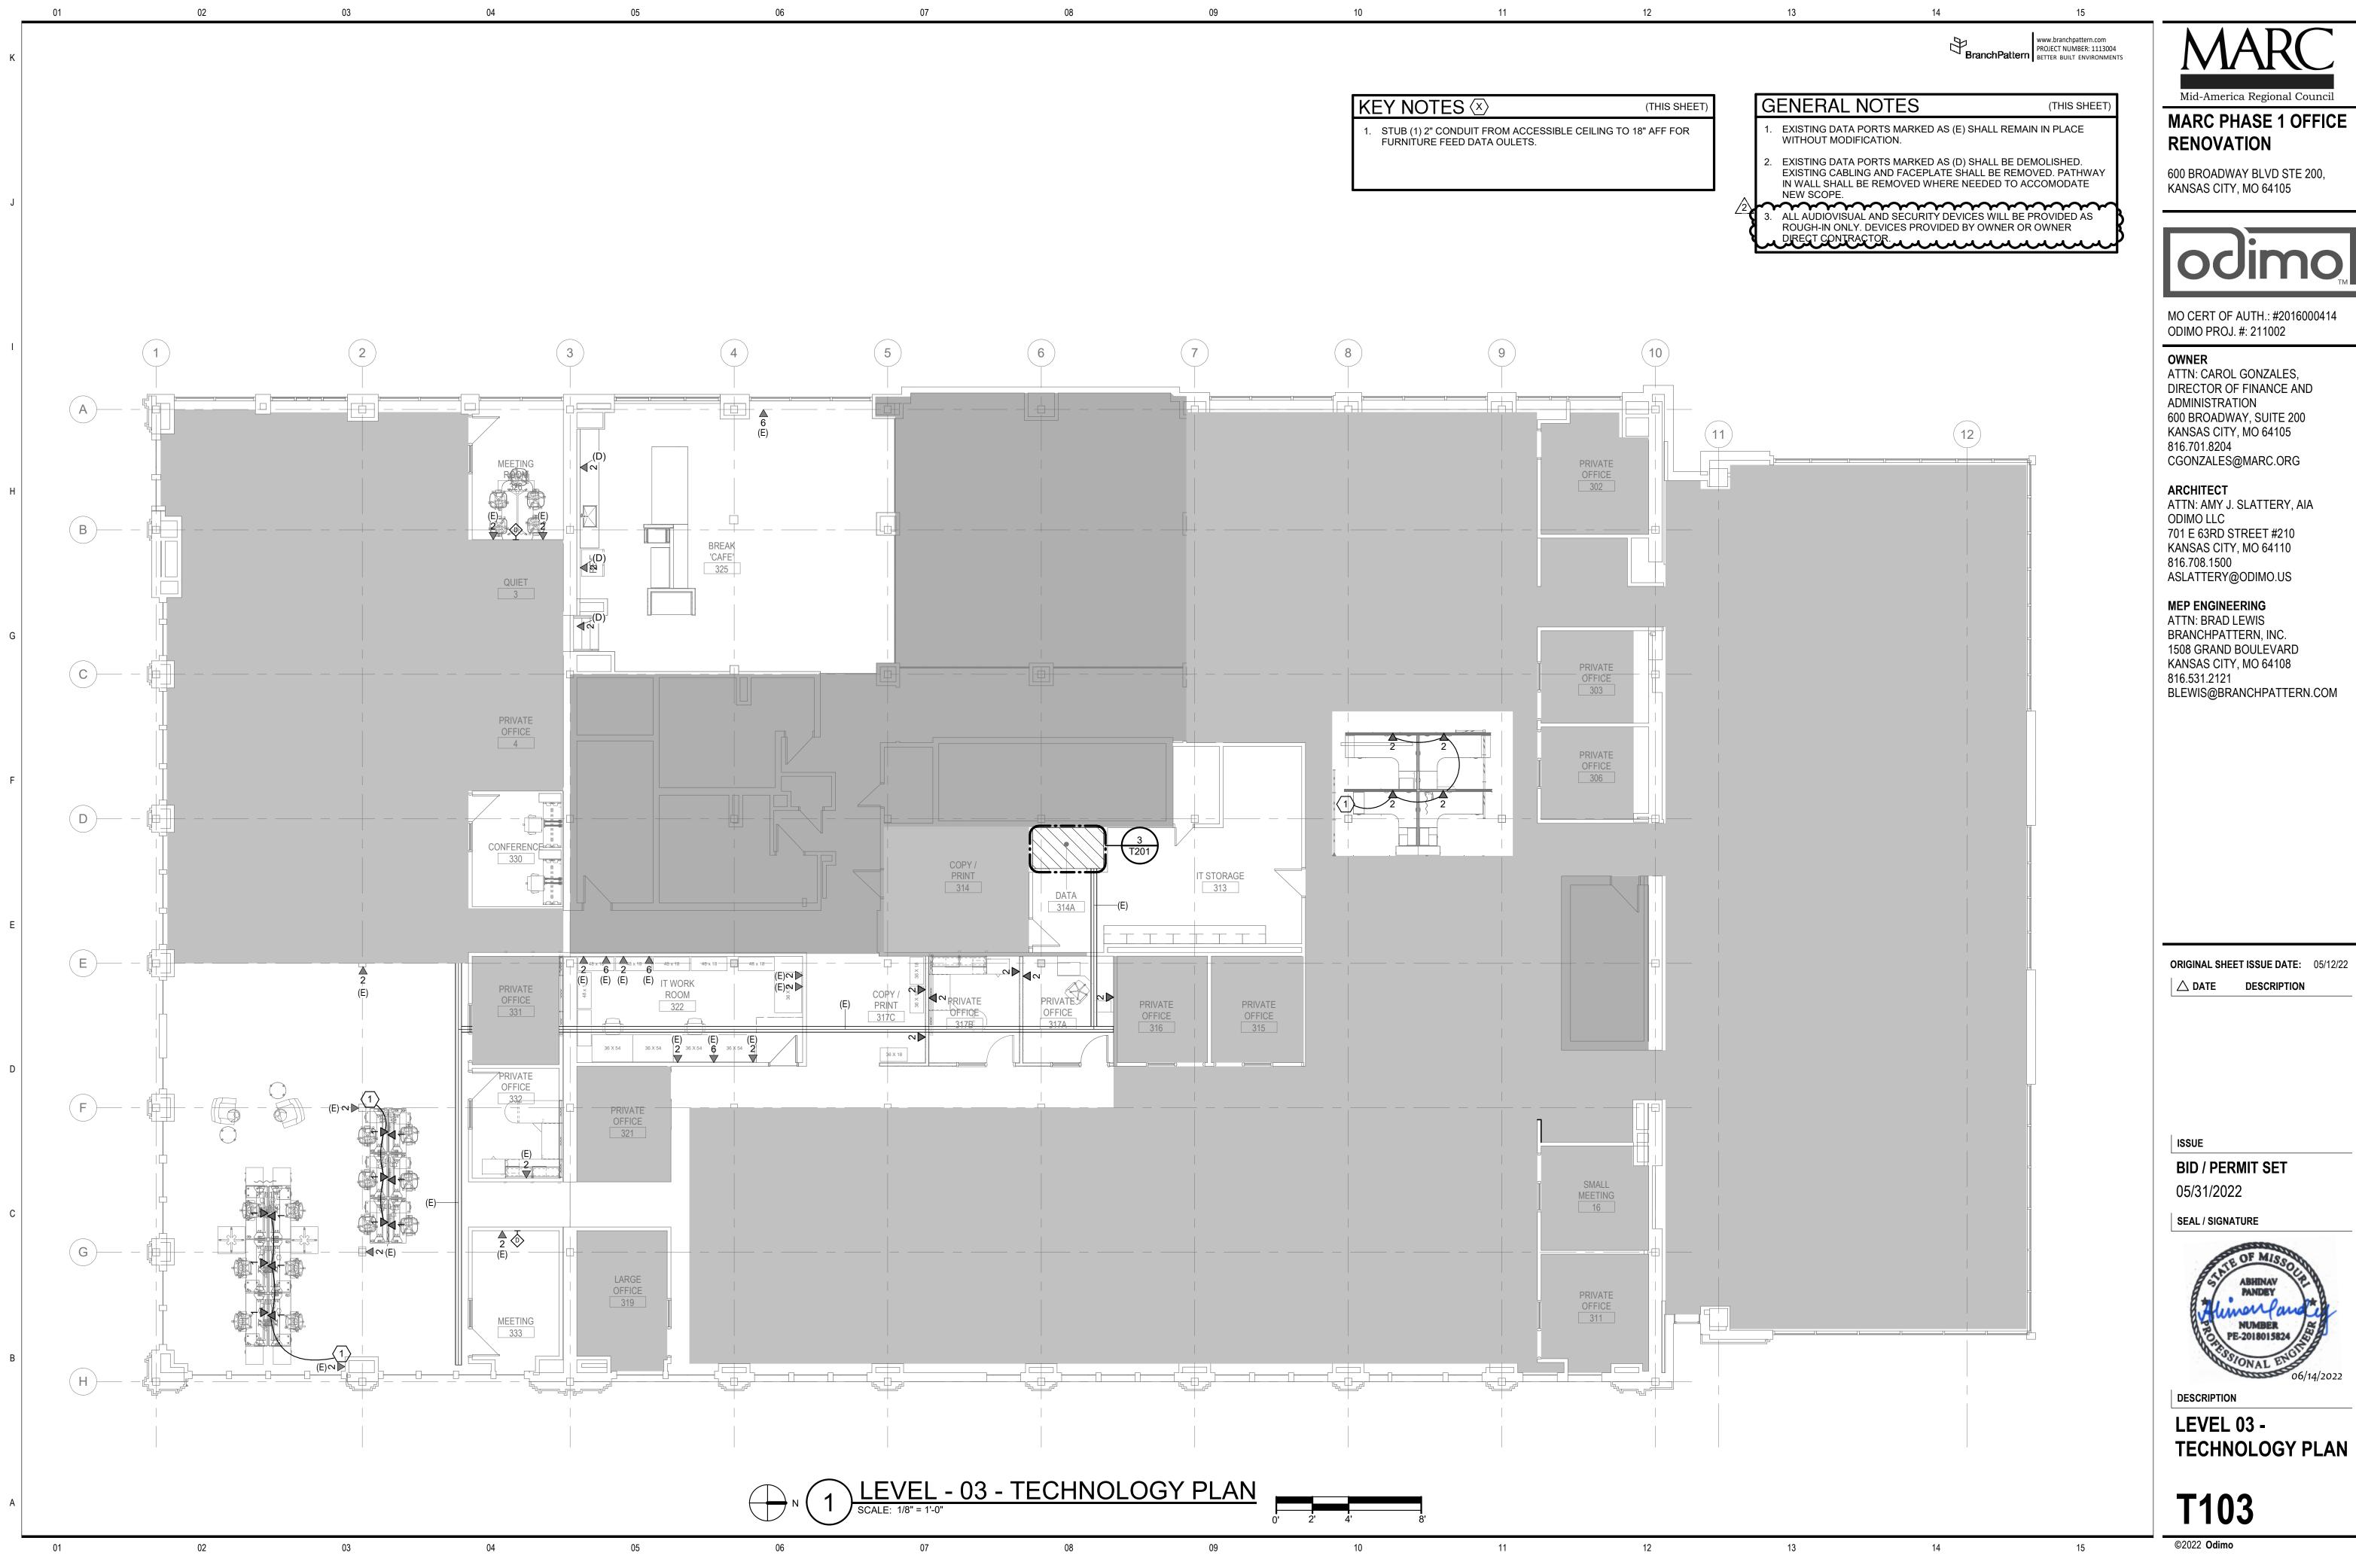

KEY NOTES 🐼	(THIS SHEI
1. STUB (1) 2" CONDUIT FROM ACCESSIBLE CEILIN FURNITURE FEED DATA OULETS.	IG TO 18" AFF FOR

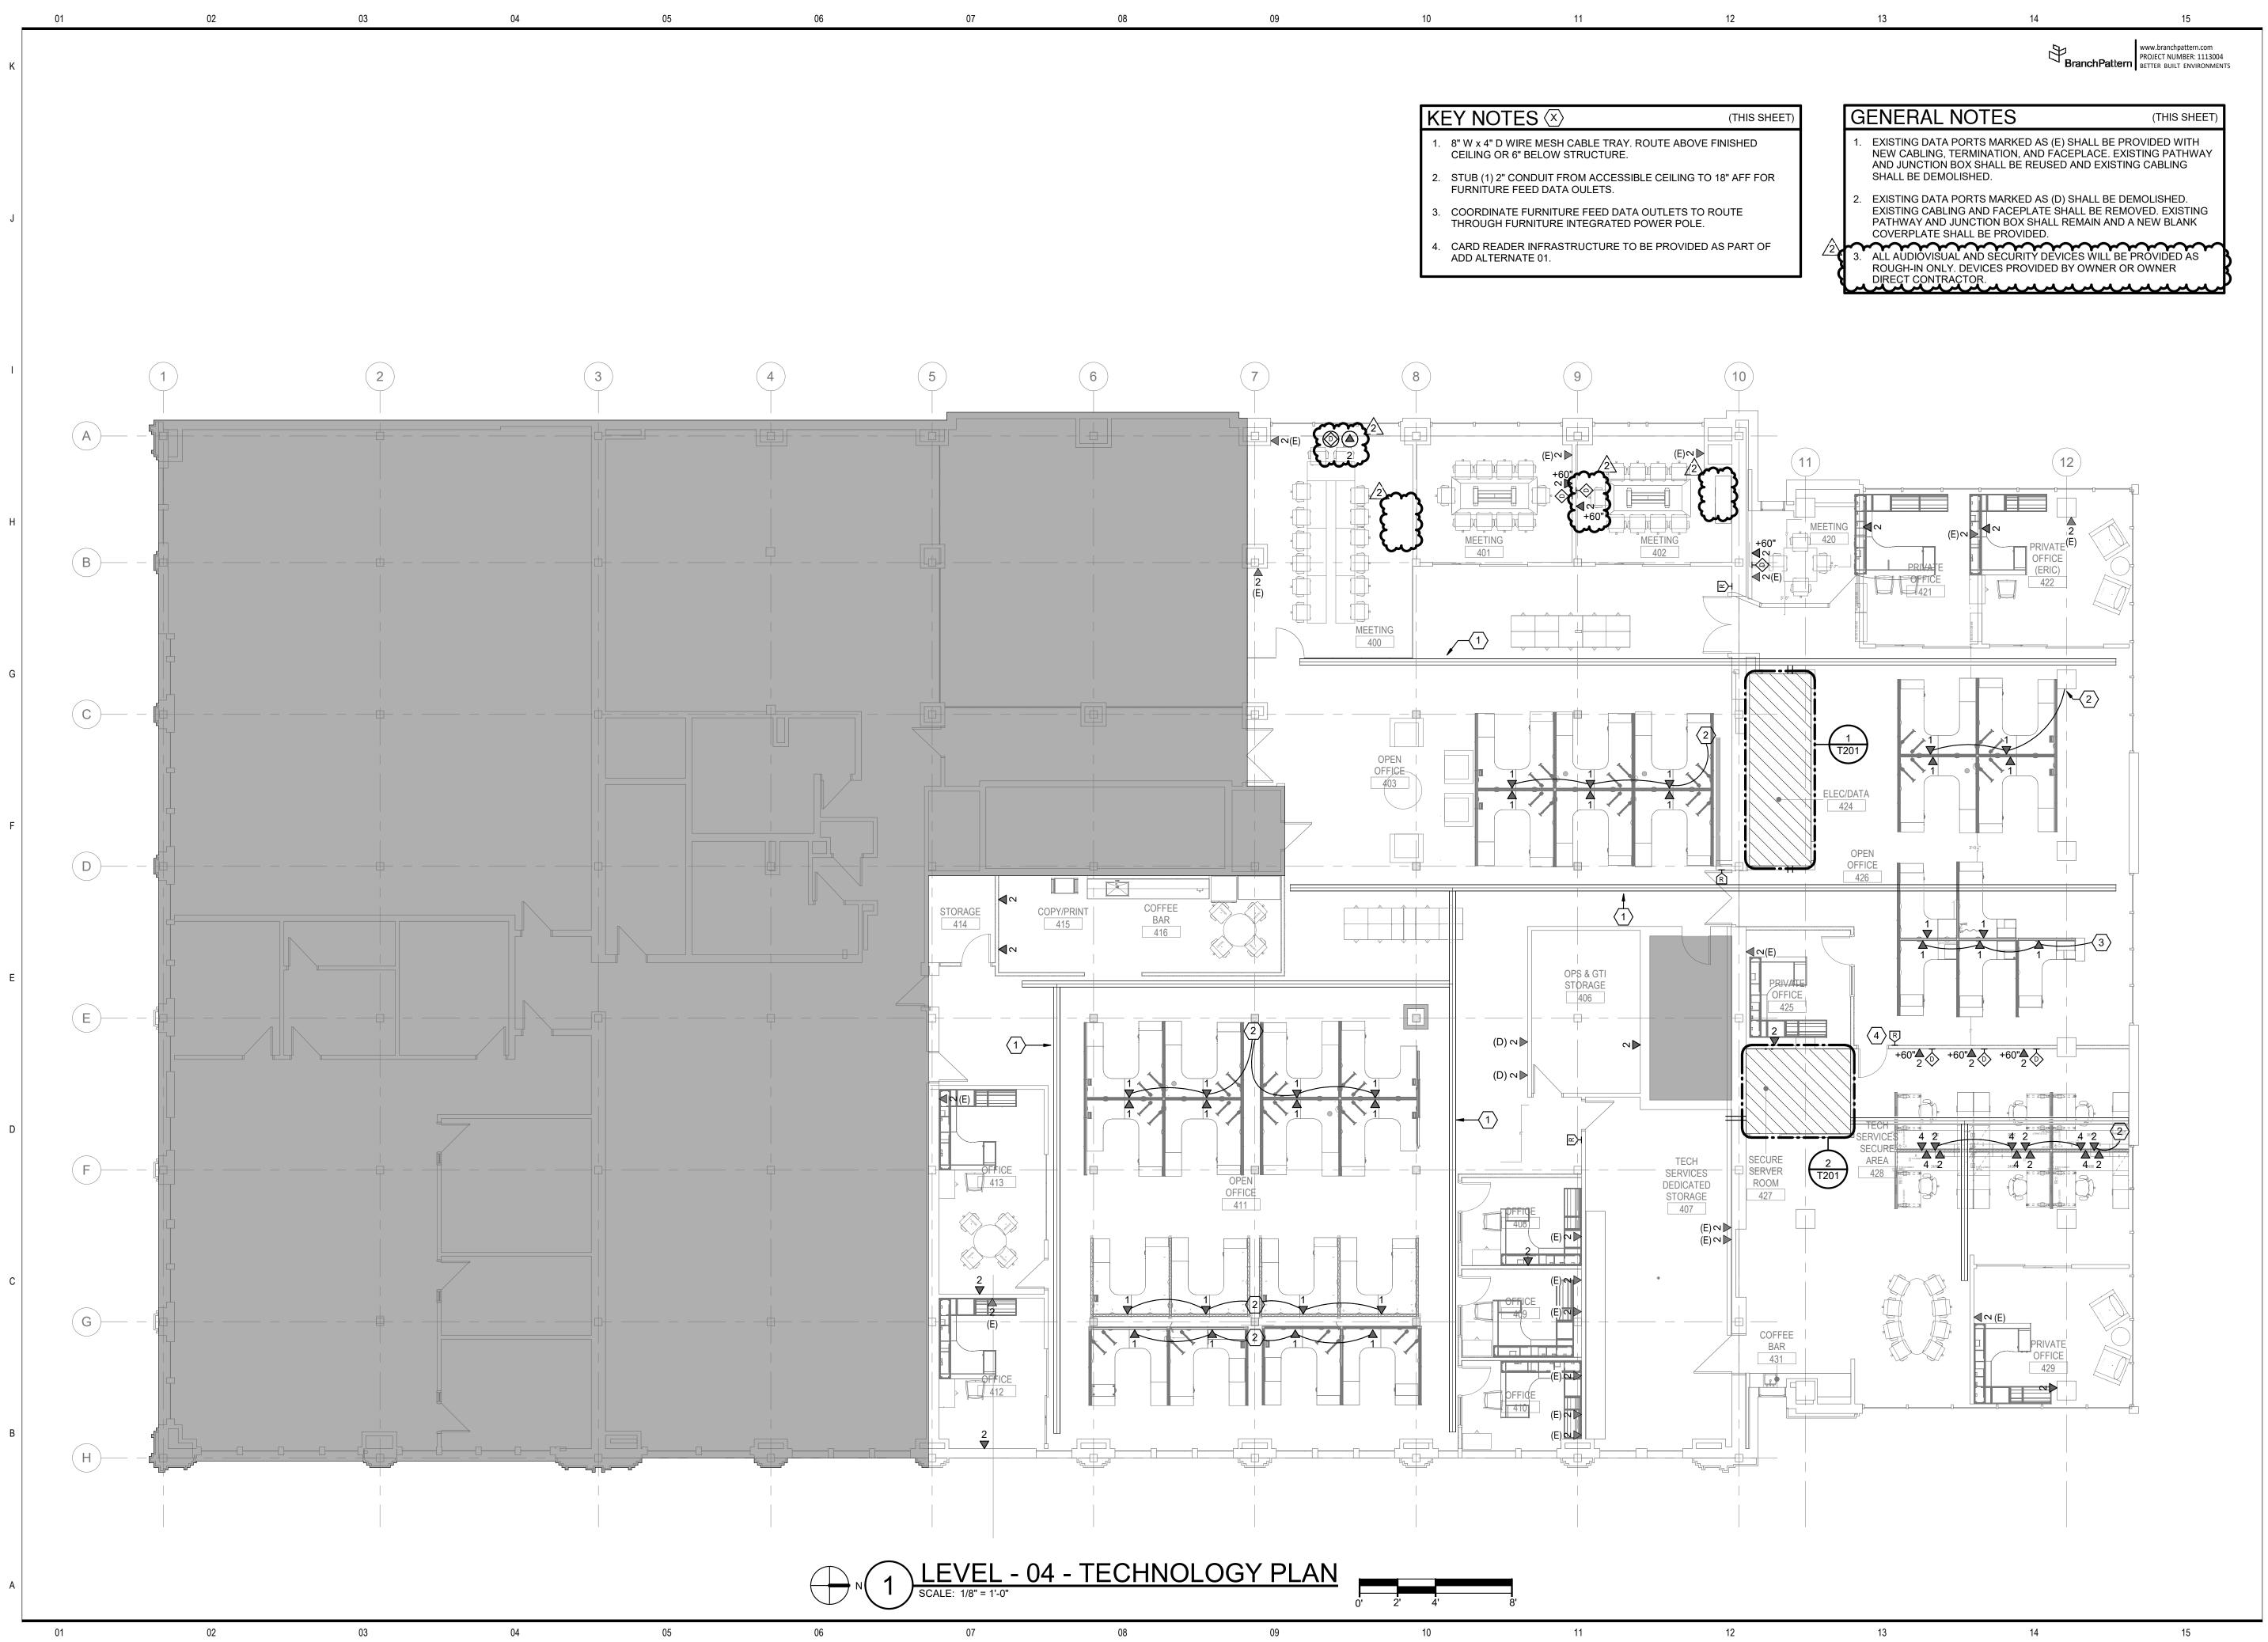



600 BROADWAY BLVD STE 200, KANSAS CITY, MO 64105



MO CERT OF AUTH.: #2016000414 ODIMO PROJ. #: 211002

OWNER

ATTN: CAROL GONZALES, DIRECTOR OF FINANCE AND ADMINISTRATION 600 BROADWAY, SUITE 200 KANSAS CITY, MO 64105 816.701.8204 CGONZALES@MARC.ORG

ARCHITECT

ATTN: AMY J. SLATTERY, AIA ODIMO LLC 701 E 63RD STREET #210 KANSAS CITY, MO 64110 816.708.1500 ASLATTERY@ODIMO.US

MEP ENGINEERING

ATTN: BRAD LEWIS BRANCHPATTERN, INC. 1508 GRAND BOULEVARD KANSAS CITY, MO 64108 816.531.2121 BLEWIS@BRANCHPATTERN.COM

\triangle date	DESCRIPTION
	ADDENDUM 01 ADDENDUM 02
ISSUE	
BID / PERI	
05/31/2022	2
SEAL / SIGNAT	URE
The PE	OF MISSOURCE ABHINAV MANDEY MANDEY 2018015824 2018015824 ONAL ENOTED 06/14/2022
DESCRIPTION	
LEVEL (TECHN()4 - DLOGY PLAN
T104	Λ